



# API Heat Transfer

## Basco/Whitlock Shell and Tube Heat Exchanger

1			JOB NO. <b>CB-18580/1</b>	
2	CUSTOMER <b>Cameron</b>	REFERENCE NO.		
3	ADDRESS		PROPOSAL NO.	
4	PLANT LOCATION		DATE <b>10/ 9/2013</b>	
5	SERVICE OF UNIT <b>Oil Cooler</b>	ITEM NO. <b>101</b>		
6	SIZE <b>10072-4"-4P</b>	TYPE <b>500(BEM)</b>	(HORIZ.) (VERT.)	CONNECTED IN
7	SQ.M SURFACE (GROSS) (EFF.) <b>18.822</b>	SHELLS/UNIT <b>ONE</b>	SQ.M SURF/SHELL (GROSS) (EFF.)	<b>18.822</b>
8	<b>PERFORMANCE OF ONE UNIT</b>			
9		SHELL SIDE		TUBE SIDE
10	FLUID CIRCULATED	<b>200 SSU Oil</b>		<b>WATER</b>
11	TOTAL FLUID ENTERING kg/HR	<b>18.17 m³/Hr</b>		<b>21.8 m³/Hr</b>
12	VAPOR kg/HR			
13	LIQUID kg/HR			
14	STEAM kg/HR			
15	NON-CONDENSIBLES kg/HR			
16	FLUID VAPORIZED OR CONDENSED kg/HR			
17	STEAM CONDENSED kg/HR			
18	SPECIFIC GRAVITY	<b>.86</b>		<b>1.0</b>
19	VISCOSITY @ TEMP cP @ °C	<b>16.0 @ 58.89</b>		<b>.716 @ 35.56</b>
20	MOLECULAR WEIGHT			
21	SPECIFIC HEAT kJ/kg-°C	<b>2.0097</b>		<b>4.1868</b>
22	THERMAL CONDUCTIVITY W/m-°C	<b>.135</b>		<b>.6248</b>
23	LATENT HEAT – VAPORS kJ/kg			
24	TEMPERATURE IN °C	<b>69.0</b>		<b>32.0</b>
25	TEMPERATURE OUT °C	<b>48.89</b>		<b>38.89</b>
26	OPERATING PRESSURE BarA			
27	NO. PASSES PER SHELL	<b>ONE</b>		<b>FOUR</b>
28	VELOCITY m/sec			<b>1.372</b>
29	PRESSURE DROP Bar	<b>.621</b>		<b>.345</b>
30	FOULING RESISTANCE (Min) m²-°C/W	<b>.000088</b>		<b>.000176</b>
31	HEAT EXCHANGED <b>175277.84</b> W	MTD CORRECTED		<b>21.778</b> °C
32	TRANSFER RATE – SERVICE <b>427.6</b>	CLEAN		W/m²-°C
33	<b>CONSTRUCTION</b>			
34	DESIGN PRESSURE BarG	<b>10.34</b>		<b>10.34</b>
35	TEST PRESSURE BarG	<b>Per Code</b>		<b>Per Code</b>
36	DESIGN TEMPERATURE (Max/Min) °C	<b>93.3 / -28.9</b>		<b>93.3 / -28.9</b>
37	TUBES <b>90/10 Cu/Ni</b> NO. <b>344</b> OD <b>9.5 mm</b> BWG <b>22</b> LENGTH <b>182.9 cm</b> PITCH <b>11.5 mm Tri</b>			
38	SHELL <b>Carbon Steel</b> ID <b>25.75 cm</b> OD <b>27.3 cm</b>	SHELL COVER (INTEG)(REMOV)		
39	BONNET/CHANNEL <b>Fab.Steel(Hog-outs)</b>	CHANNEL COVER		
40	TUBESHEET-STATIONARY <b>Carbon Steel</b>	TUBESHEET-FLOATING		
41	BAFFLES - CROSS <b>Carbon Steel</b> TYPE <b>Seg.</b>	FLOATING HEAD COVER		
42	BAFFLES - LONG TYPE	IMPINGEMENT PROTECTION		
43	TUBE SUPPORTS			
44	TUBE TO TUBESHEET JOINT <b>Mechanically Rolled</b>			
45	GASKETS <b>Compressed Fiber</b>	PACKING		
46	CONNECTIONS-SHELL SIDE IN <b>3" - 150#</b> OUT <b>3" - 150#</b> RATING <b>ANSI RF SO</b>			
47	BONNET/CHANNEL SIDE IN <b>2.5"</b> OUT <b>2.5"</b> RATING <b>NPT</b>			
48	CORROSION ALLOWANCE – SHELL SIDE <b>1.6 mm on C. Steel</b> TUBE SIDE <b>1.6 mm on C. Steel</b>			
49	CODE REQUIREMENTS <b>ASME Sec. VIII, Div. 1 (Latest Addenda)</b>	TEMA CLASS <b>C</b>		
50	OTHER			
51	REMARKS			
52	<b>Cameron P/N AAP1401429-</b>			
53	<b>Includes 20% Oversizing</b>			
54				

Compression Systems  
 3101 Broadway, PO Box 209  
 Buffalo, NY 14225-0209 USA  
 Tel. 716.896.6600  
 Fax 716.896.1233



Tue Nov 19 10:29:51 2013

**Heat Exchanger Specification**

Metric Units

Customer: ROS ROCA INDOX CRYO-ENERGY, S.L. - Bolivia & Ecuador		Job No.: CB-18580,1
Service of Unit: 3R2MSGP-7ARC : A/C		Cooper PN: A3806480 - 00840
Size: 1112.5 / 15 X 17 X 4978.4		Effective Surface: 1444.2 m <sup>2</sup>
<b>Performance</b>		
Fluid Allocation	<b>Shell</b>	<b>Tube</b>
Fluid Name	Nitrogen	Water
Fluid Quantity, Total	14992.6 m <sup>3</sup> /Hr*	132.8 m <sup>3</sup> /Hr
Vapor (In/Out) Kg/Hr	0.0 / 0.0	
Liquid Kg/Hr		132767.8
Condensate Kg/Hr	0.0	
Non Condensables Kg/Hr	104539.4	
Temperature (In/Out) Deg C	94.3 / 40.0	32.0 / 42.3
Specific Heat Kcal/KgC	0.25	1.0
Inlet Pressure BAR(abs)	26.4	
Core Velocity	m/s	1.8 m/s
Pressure Drop BAR	0.059	0.505
Fouling Resistance Hrm <sup>2</sup> C/Kcal	0.0001	0.0002
Heat Ex.: 1363595.3 Kcal/Hr // LMTD: 23.5 Deg C // Transfer Rate: 58.1 Kcal/Hrm <sup>2</sup> C		
<b>Construction</b>		
Design/Test Pressure BAR(g)	39.6 / 51.6	10.3 / 13.4
Design Temperature (min/max) Deg C	-28.9 / 176.7	-28.9 / 65.6
Number of Passes	1	2
Corrosion Allowance mm	1.5875	1.5875
Connections: Size (In/Out) in	12.0 / 12.0**	6.0 / 6.0**
Connections: Rating		150 PSIG**
Tube No.: 255	OD: 0.6250 in**	Thk: 18.0 BWG**
Length: 4978.4 mm	Pitch: 38.1 mm	---> 30 deg. triangular
Tube/Fin Arrangement: BARE with ALUMINUM fins // Tube Material: 90/10 CuNi		
Shell: STEEL Shell Cover: STEEL ID / OD: 1066.8 mm / 1112.5 mm		
Bonnet, Supply: STEEL // Bonnet, Return: STEEL		
Tubesheet, Stationary: STEEL // Tubesheet, Floating: STEEL		
Bypass Seal: Silicone Rubber	Tubesheet Joint: Rolled/Grooved	Expansion Joint: O-Ring
Gasket, Shell: Non-Asbestos // Gasket, Tube: Non-Asbestos // Gasket, Floating Head: Non-Asbestos		
Code Requirements: A.S.M.E. Section VIII Division 1		
Weights-Dry: 7801.9 Kg // Wet: 8151.1 Kg // Bundle: 2041.2 Kg		
Remarks: * Measured @ 6.41 BAR(abs); 36.8 Deg C; 0.0 %RH		
** ASME Nominal Values		
Notes: ***Cooler Performance based on Final Aero Design		

Continue

Compression Systems  
 3101 Broadway, PO Box 209  
 Buffalo, NY 14225-0209 USA  
 Tel. 716.896.6600  
 Fax 716.896.1233



Tue Nov 19 10:15:10 2013

**Heat Exchanger Specification**

Metric Units

Customer: ROS ROCA INDOX CRYO-ENERGY, S.L. - Bolivia & Ecuador		Job No.: CB-18580,1
Service of Unit: 3R2MSGP-7ARC : I/C #1		Cooper PN: A3806478 - 00840
Size: 1071.9 / 16 X 14 X 4699.0		Effective Surface: 1201.8 m <sup>2</sup>
Performance		
Fluid Allocation	Shell	Tube
Fluid Name	Nitrogen	Water
Fluid Quantity, Total	14992.6 m <sup>3</sup> /Hr*	155.6 m <sup>3</sup> /Hr
Vapor (In/Out) Kg/Hr	0.0 / 0.0	
Liquid Kg/Hr		155470.4
Condensate Kg/Hr	0.0	
Non Condensables Kg/Hr	104539.4	
Temperature (In/Out) Deg C	99.4 / 40.5	32.0 / 41.6
Specific Heat Kcal/KgC	0.25	1.0
Inlet Pressure BAR(abs)	11.2	
Core Velocity	m/s	2.4 m/s
Pressure Drop BAR	0.072	0.827
Fouling Resistance Hrm <sup>2</sup> C/Kcal	0.0001	0.0002
Heat Ex.: 1480105.5 Kcal/Hr // LMTD: 25.7 Deg C // Transfer Rate: 60.1 Kcal/Hrm <sup>2</sup> C		
Construction		
Design/Test Pressure BAR(g)	19.6 / 25.6	10.3 / 13.4
Design Temperature (min/max)Deg C	-28.9 / 176.7	-28.9 / 65.6
Number of Passes	1	2
Corrosion Allowance mm	1.5875	1.5875
Connections: Size (In/Out) in	16.0 / 12.0**	6.0 / 6.0**
Connections: Rating		150 PSIG**
Tube No.: 224	OD: 0.6250 in**	Thk: 18.0 BWG**
Length: 4699.0 mm	Pitch: 38.1 mm	---> 30 deg. triangular
Tube/Fin Arrangement: BARE with ALUMINUM fins // Tube Material: 90/10 CuNi		
Shell: STEEL Shell Cover: STEEL ID / OD: 1046.5 mm / 1071.9 mm		
Bonnet, Supply: STEEL // Bonnet, Return: STEEL		
Tubesheet, Stationary: STEEL // Tubesheet, Floating: STEEL		
Bypass Seal: Silicone Rubber	Tubesheet Joint: Rolled/Grooved	Expansion Joint: O-Ring
Gasket, Shell: Non-Asbestos // Gasket, Tube: Non-Asbestos // Gasket, Floating Head: Non-Asbestos		
Code Requirements: A.S.M.E. Section VIII Division 1		
Weights-Dry: 5533.9 Kg // Wet: 5837.8 Kg // Bundle: 1678.3 Kg		
Remarks: * Measured @ 6.41 BAR(abs); 37.4 Deg C; 0.0 %RH		
** ASME Nominal Values		
Notes: ***Cooler Performance based on Final Aero Design		

Continue

Compression Systems  
 3101 Broadway, PO Box 209  
 Buffalo, NY 14225-0209 USA  
 Tel. 716.896.6600  
 Fax 716.896.1233



Tue Nov 19 10:24:42 2013

**Heat Exchanger Specification**

Metric Units

Customer: ROS ROCA INDOX CRYO-ENERGY, S.L. - Bolivia & Ecuador		Job No.: CB-18580,1
Service of Unit: 3R2MSGP-7ARC : I/C #2		Cooper PN: A3806479 - 00840
Size: 1087.1 / 16 X 14 X 4699.0		Effective Surface: 1201.8 m <sup>2</sup>
<b>Performance</b>		
Fluid Allocation	<b>Shell</b>	<b>Tube</b>
Fluid Name	Nitrogen	Water
Fluid Quantity, Total	14992.6 m <sup>3</sup> /Hr*	155.6 m <sup>3</sup> /Hr
Vapor (In/Out) Kg/Hr	0.0 / 0.0	
Liquid Kg/Hr		155470.4
Condensate Kg/Hr	0.0	
Non Condensables Kg/Hr	104539.4	
Temperature (In/Out) Deg C	85.1 / 38.6	32.0 / 39.6
Specific Heat Kcal/KgC	0.25	1.0
Inlet Pressure BAR(abs)	16.3	
Core Velocity	m/s	2.4 m/s
Pressure Drop BAR	0.053	0.827
Fouling Resistance Hrm <sup>2</sup> C/Kcal	0.0001	0.0002
Heat Ex.: 1166460.4 Kcal/Hr // LMTD: 20.2 Deg C // Transfer Rate: 60.5 Kcal/Hrm <sup>2</sup> C		
<b>Construction</b>		
Design/Test Pressure BAR(g)	31.0 / 40.3	10.3 / 13.4
Design Temperature (min/max) Deg C	-28.9 / 176.7	-28.9 / 65.6
Number of Passes	1	2
Corrosion Allowance mm	1.5875	1.5875
Connections: Size (In/Out) in	15.0 / 14.0**	6.0 / 6.0**
Connections: Rating		150 PSIG**
Tube No.: 224	OD: 0.6250 in**	Thk: 18.0 BWG**
Length: 4699.0 mm	Pitch: 38.1 mm	---> 30 deg. triangular
Tube/Fin Arrangement: BARE with ALUMINUM fins // Tube Material: 90/10 CuNi		
Shell: STEEL Shell Cover: STEEL ID / OD: 1046.5 mm / 1087.1 mm		
Bonnet, Supply: STEEL // Bonnet, Return: STEEL		
Tubesheet, Stationary: STEEL // Tubesheet, Floating: STEEL		
Bypass Seal: Silicone Rubber	Tubesheet Joint: Rolled/Grooved	Expansion Joint: O-Ring
Gasket, Shell: Non-Asbestos // Gasket, Tube: Non-Asbestos // Gasket, Floating Head: Non-Asbestos		
Code Requirements: A.S.M.E. Section VIII Division 1		
Weights-Dry: 6378.9 Kg // Wet: 6658.8 Kg // Bundle: 1698.7 Kg		
Remarks: * Measured @ 6.41 BAR(abs); 36.8 Deg C; 0.0 %RH		
** ASME Nominal Values		
Notes: ***Cooler Performance based on Final Aero Design		


Continue



삼성테크윈

<b>13. HEAT EXCHANGER MATERIAL of CONSTRUCTION</b>			YES	
<b>13-1. INTERCOOLER</b>				
Type		Water-In-Tube		
Shell size		D430 x L874		
Tubes		Externally L-Foot Finned Tube		
Dimensions	mm	OD12.0 x T1.0 x L823		
Material (tube/fin)		COPPER(C1220T) / COPPER(C1220)		
Tube Number		126		
Fouling Resistance(min.)	m2.Hr. °C/kcal	0.00035		
Design Temperature	°C	100		
Design/Test Pressure	kg/cm <sup>2</sup> .G	5 / 10.0		
Shell		Air Side		
Material		FCD400		
Design Temperature	°C	200		
Design/Test Pressure	kg/cm <sup>2</sup> .G	10.5/13.1		
Fouling resistance(min.)	m2.Hr. °C/kcal	0.00035		
Water Separator		Automatic Water Separation Structure		
Auto Trap				
Type		Elec.Level Sensor		
Manufacture & Model		BECO / DM150		
<b>13-2. AFTER COOLER</b>				
Type		Water-In-Tube		
Shell size		D410 x L874		
Tubes		Externally L-Foot Finned Tube		
Dimensions	mm	OD12.0 x T1.0 x L823		
Material (tube/fin)		COPPER(C1220T) / COPPER(C1220)		
Tube Number		126		
Fouling Resistance(min.)	m2.Hr. °C/kcal	0.00035		
Design Temperature	°C	100		
Design/Test Pressure	kg/cm <sup>2</sup> .G	5 / 10.0		
Shell		Air Side		
Material		FCD400		
Design Temperature	°C	200		
Design/Test Pressure	kg/cm <sup>2</sup> .G	10.5/13.1		
Fouling resistance(min.)	m2.Hr. °C/kcal	0.00035		
Water Separator		Automatic Water Separation Structure		
Auto Trap				
Type		Elec.Level Sensor		
Manufacture & Model		BECO / DM150		
<b>13-3. OIL COOLER</b>				
Manufacturer		Samsung STD		
Type	mm	Water - in - Tube		
Tube Outside Diameter		OD8.0 x T0.8 x L988		
Tube Number		170		
Design/Test Pressure	°C	Shell Side: 10.0/12.5, Tube Side: 6.5/7.5		
Disign Temperature	mm	Shell Side: 100, Tube Side: 100		
Material (Tube)		COPPER(C1220T)		
Fouling Resistance	m2.Hr. °C/kcal	0.00035		
<b>14. INLET AIR FILTER</b>			YES	
Filter Case				
Material		SS400, Anti Rust Coated		
Filter Element		Catridge , circular		
Manufacture / Model		Samsung / FA-6386		
Specification		2 microns, 2500scfm / each		
Element / Q'ty		Efficiency to be 99.5%, 2 EA		
<b>15. SHOP TEST</b>			YES	
Compressor				
Impeller		Spin Test(115% Designed RPM)		
Gear Box & Cooler Case		Hydro Pressure Test		
Performance Test		Samsung STD		Per ASME PTC 10
Sound Level		Max 95 dB(A) at Free Field Condition		
Main Motor		Winding Resistance Measurement,NoiseLevel,No-Load,Locked rotor test		

## HEAT EXCHANGER SPECIFICATION SHEET

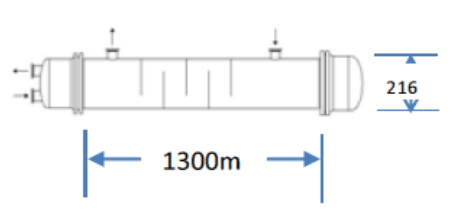Customer		MADE BY	CHECKED BY	APPROVED BY
		Date		Revision No.
Address		2014.01.30		None
Plant Location				
Service of Unit		OIL COOLER		Item No.
Size	Type	Horz. (Hor/Vert)		Connected In 1 Parallel 1 Series
Surf/Unit (Gross/Eff)	14.29	m2	Shells/Unit 1	Surf/shell(Gross/Eff.) 14.29 m2
<b>PERFORMANCE OF ONE UNIT</b>				
Fluid Allocation		Shell Side		Tube Side
Fluid Name		Oil(ISO VG 32)		Cooling Water
Fluid Quantity, Total		165		130
Vapor(In/Out)				
Liquid		8345.42		8345.42
Steam				
Water				7737.53
Noncondensable				7737.53
Temperature (In/Out)		65.0		48.0
Viscosity, Liquid		12.690		19.134
Molecular Weight, Vapor				
Molecular Weight, Noncondensable				
Specific Heat		2.04299		1.9934
Thermal Conductivity		0.137175		0.138
Inlet Pressure		4.0		3.0
Velocity		0.26		0.77
Pressure Drop, Allow./Calc.		1.00		0.8
Fouling Resistance (Min.)		0.00041		0.00041
Heat Exchanged		69,249		18.47
Transfer rate, Service		255		Clean
				kcal/m2.Hr. °C
<b>CONSTRUCTION OF ONE SHELL</b>				Sketch(Bundle/Nozzle Orientation)
		Shell Side		Tube Side
Design/Test Pressur		10 / 11		6.5 / 7.15
Design Temperature		100		100
No. Passes per Shell		1		2
Corrosion Allwance		3.0		3.0
Connections		ASME #150 1-1/2" SO.RF.		2" PF
Size & Rating		ASME #150 1-1/2" SO.RF.		2" PF
		-		-
				
Tube No.	106	OD	9.52	mm; Thk(Min/Avg) 0.7
Tube Type	Finned Tube		Material	SB111-C70600
Shell (O.D/I.D)	216.3/204.6		Shell Cover	N/A (Integ.)(Remov.)
Channel or Bonnet	Channel		Channel Cover	N/A (Integ.)(Remov.)
Tubesheet-Stationary	Confined		Tubesheet-Floating	Confined
Floating Head Cover			Impingement Protection	Y / N
Baffles-Cross	SINGLE SEG	Type	-	%Cut Spacing:c/c - Inlet - mm
Baffles-Long	N/A	Seal Type		
Bypass Seal Arrangement	N/A		Tube-Tubesheet Joint	Expanding + Welding
Expansion Joint	-		Type	
ρV2- Inlet Nozzle	Bundle Entrance		Bundle Exit	
Gaskets-Shell Side	Non-Asbe.		Tube Side	Non-Asbe.
-Floating Head	Non-Asbe.			
Code requirements	ASME SEC VIII DIV.1(WITHOUT STAMP)		Code Stamp: Y / N	TEMA Class 'C'
Weight/Shell	133.2	kg	Filled with Water	222.2
			Bundle	75
Remarks				
1. Detailed shell & bundle's structure, dimensions, and coolant specifications may be determined by agreement between STW and vendor.				
2. Float side structure shall be fixed type.				
3. Connections specification and dimensions for oil and water side may be determined by STW and vendor agree to STW's requirements.				
4. Main Oil Pump power consumption is also considered as a Oilcooler heat duty				
5. Tube type is subject to manufacture's recommendation.				



### Design Data Sheet

**Designation:** ..... CO<sub>2</sub> Gas Cooler (Ucarsol Condenser)  
**Tag Number:** ..... E-11502-01  
**UE Unit:** ..... 115-2  
**Stockcode:** ..... B0084431

**HEAT EXCHANGER SPECIFICATION:**

**Duty:** ..... 253.3 kW [865,065 Btu/hr]  
**Surface Area:** ..... 3.4 m<sup>2</sup> [36.6 Ft<sup>2</sup>]  
**Design Code:** ..... ASME Section VIII, Div.1, Latest edition w/ U-Stamp  
**Type:** ..... Gasketed Plate and Frame

**COLD SIDE:**

**Media:** ..... Cooling Water  
**Flow:** ..... 19,840 kg/hr [43,740 lbs/hr]  
**Inlet Pressure:** ..... 2.6 Bara [37.7 Psia]  
**Inlet Temperature:** ..... 32°C [89.6°F]  
**Outlet Temperature:** ..... 43°C [109.4°F]  
**Passes per shell:** ..... 1  
**Design Pressure:** ..... 10 Barg [145 Psig]  
**Design Temperature:** ..... 0°C /160°C [32°F /320°F]  
**Connections:**  
    **Inlet** ..... 2"-150#RF  
    **Outlet** ..... 2"-150#RF

**HOT SIDE:**

**Media:** ..... Vapor CO<sub>2</sub> & Steam  
**CO2 Inlet Flow:** ..... 563 kg/hr [1241 lbs/hr]  
**Steam Inlet Flow:** ..... 375 kg/hr [827 lbs/hr]  
**Inlet Pressure:** ..... 1.70 Bara [24.7 Psia]  
**Inlet Temperature:** ..... 102.2°C [216°F]  
**Outlet Temperature:** ..... 49°C [120.2°F]  
**Design Pressure:** ..... 10 Barg [145 Psig]  
**Design Temperature:** ..... 0°C /160°C [32°F /320°F]  
**Connections:**  
    **Inlet** ..... 2"-150#RF  
    **Outlet** ..... 2"-150#RF


**MATERIALS:**

**Plates:** ..... 316L Stainless Steel – (qty 26)  
**Seals:** ..... EPDMP Clip-on  
**Connection Liner:** ..... Stainless Steel  
**Prohibited Materials (wetted parts):** ..... Aluminum, zinc, galv. metals, copper, Viton, BunaN




Designed constructed and stamped in accordance with 2013 ASME Code and latest Addendum.

This is a general drawing. Additional parts, if required, like protection sheets, inspection covers, etc. are not displayed.

**FRAME PLATE  
(FIXED)**

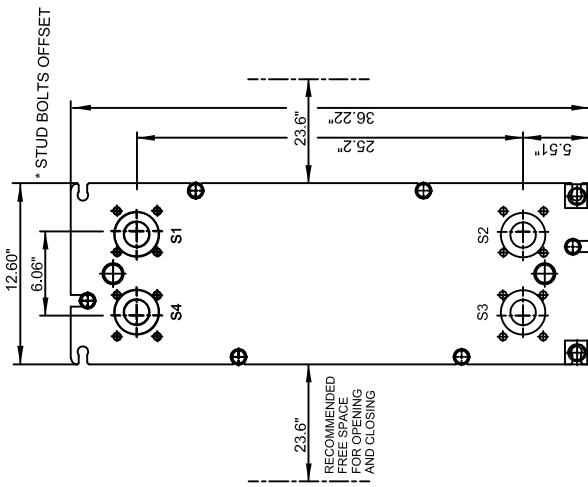

**PRESSURE PLATE  
(MOVABLE)  
SECTION A-A**

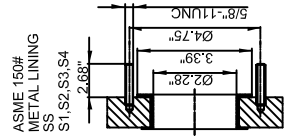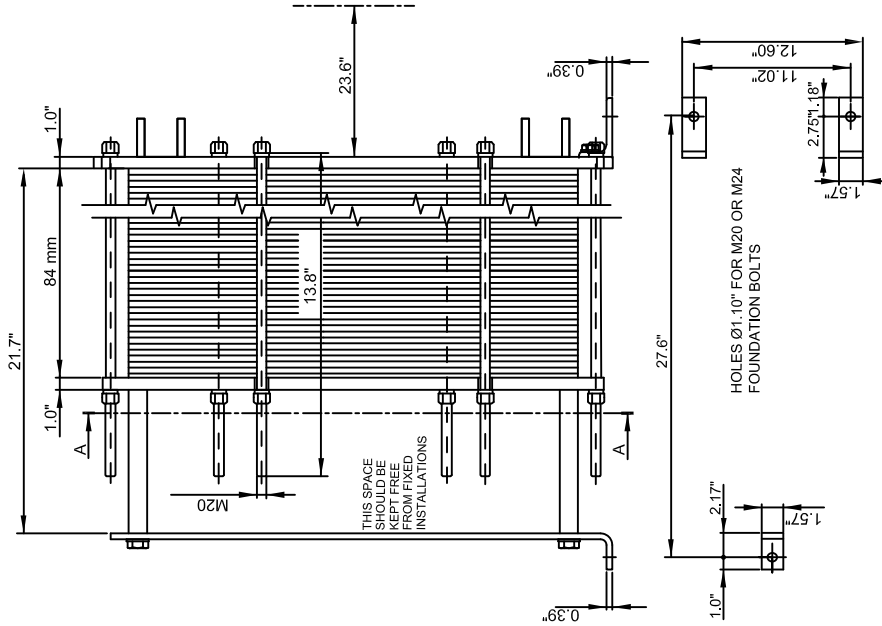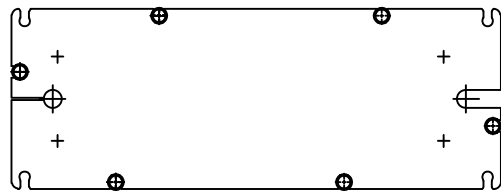

REMARKS:	SIDE 1	SIDE 2	GASKET	EPDMP CLIP-ON
DESIGN PRESSURE	146 psi	146 psi	PLATE MATERIAL	ALLOY 316
TEST PRESSURE	189.8 psi	189.8 psi	PLATE THICKNESS	0.50 mm
MAX TEMPERATURE	320 °F	320 °F	HEATING SURFACE	33.2 ft²
MIN TEMPERATURE	32 °F	32 °F	PLATE GROUPING	1*11L/1*12L
MAWP	146 psi	146 psi	WEIGHT WITH WATER	348 lb
MDMT	-20 °F		NETWEIGHT	326 lb

TOTAL LENGTH	29.7"
TOTAL WIDTH	12.6"
TOTAL HEIGHT	36.2"

REV.1:REVISED DESIGN PRESS.

ALL DIMENSIONS IN INCHES

INLET	OUTLET	TEMP.	FLOW RATE	PRESSURE DROP	LIQUID VOL.
S1	S2	216.0 °F	2068 lb/h	2.149 psi	0.17 ft³
S3	S4	89.6 °F	43740 lb/h	3.091 psi	0.19 ft³


SUPPLIER	REF. 71586-10	ITEM NO. E-11502-01
AGENT / REF. / 1815433		
CUSTOMER NAME / REF. NO. Union Engineering North America, LLC / 41109		
SIGN. CFN		RISK CATEGORY N/A

PLATE HEAT EXCHANGER

# M6-MFG

ASME AS BUILT

2014-05-13



SERIAL NUMBER 30115-74255

DATE 2014-03-13

REV NO. 1



# E-11502-01 CO2 GAS COOLER

## FORM U-1 MANUFACTURER'S DATA REPORT FOR PRESSURE VESSELS

As Required by the Provisions of the ASME Code Rules, Section VIII, Division 1

1. Manufactured and certified by Alfa Laval Inc., 5400 International Trade Drive, Richmond, Virginia, 23231  
(Name and address of Manufacturer)
2. Manufactured for Union Engineering North America, LLC, 1 Industry Drive, Palm Coast, FL, 32137  
(Name and address of Purchaser)
3. Location of installation 2794 Old Richburg Road, Richburg, SC, 29729  
(Name and address)
4. Type Vertical Plate Heat Exchanger 30115-74255  
(Horiz., vert., or sphere) (Tank, separator, jkt. vessel, heat exh., etc.) (Mfg's serial No.)
5. ASME Code, Section VIII, Div. 1 N/A 30115-74255.1 34746 2014  
(CRN) (Drawing No.) (Nat'l. Bd. No.) (Year built)
6. ASME Code, Section VIII, Div. 1 2013/ N/A N/A N/A  
Edition and Addenda (date) Code Case No. Special Service per UG-120(d)

*Items 6-11 incl. to be completed for single wall vessels, jackets of jacketed vessels, shell of heat exchangers, or chamber of multichamber vessels.*

6. Shell (a) No. of course(s): N/A (b) Overall length: 0'

Course(s)			Material	Thickness		Long. Joint (Cat. A)			Circum. Joint (Cat. A, B, & C)			Heat Treatment	
No.	Diameter	Length	Spec./Grade or Type	Nom.	Corr.	Type	Full, Spot, None	Eff.	Type	Full, Spot, None	Eff.	Temp.	Time
	<u>N/A</u>	<u>N/A</u>	<u>N/A</u>	<u>N/A</u>	<u>N/A</u>	<u>N/A</u>	<u>N/A</u>	<u>N/A</u>	<u>N/A</u>	<u>N/A</u>	<u>N/A</u>	<u>N/A</u>	<u>N/A</u>

7. Heads: (a) SA-516-70 (b) SA-516-70  
(Mat'l Spec. No., Grade or Type) (H.T. - Time & Temp.) (Mat'l Spec. No., Grade or Type) (H.T. - Time & Temp.)

	Location (Top, Bottom, Ends)	Thickness		Radius		Elliptical Ratio	Conical Apex Angle	Hemispherical Radius	Flat Diameter	Side to Pressure		Category A		
		Min.	Corr.	Crown	Knuckle					Convex	Concave	Type	Full, Spot, None	Eff.
(a)	<u>Fixed</u>	<u>1"</u>	<u>0"</u>	<u>N/A</u>	<u>N/A</u>	<u>N/A</u>	<u>N/A</u>	<u>N/A</u>	<u>36" X 13"</u>			<u>N/A</u>	<u>N/A</u>	<u>N/A</u>
(b)	<u>Movable</u>	<u>1"</u>	<u>0"</u>	<u>N/A</u>	<u>N/A</u>	<u>N/A</u>	<u>N/A</u>	<u>N/A</u>	<u>34" X 13"</u>			<u>N/A</u>	<u>N/A</u>	<u>N/A</u>

If removable, bolts used (describe other fastening) SA193-B7 (6) 0.787" (M20 actual) BOLTS  
(Mat'l, Spec. No., Grade, Size, No.)

8. Type of jacket N/A Jacket closure N/A  
(Describe as ogee & weld, bar, etc.)

If bar, give dimensions N/A If bolted, describe or sketch.

9. MAWP 146 psi N/A at max. temp. 320 °F N/A Min. design metal temp. -20 °F at 146 psi  
(internal) (external) (internal) (external)

10. Impact test NO (Impact Exemption UCS-66(a), (b), UHA-51, UNF-65, as applicable) at test temperature of N/A  
(Indicate yes or no and the component(s) impact tested)

11. Hydro., pneu., or comb. test press. HYDRO at 190 psi Proof test N/A

*Items 12 and 13 to be completed for tube sections.*

12. Tubesheet: N/A N/A N/A N/A N/A  
Stationary (Mat'l Spec. No.) Dia., (subject to press.) Nom. thk. Corr. Allow. Attachment (welded or bolted)
- N/A N/A N/A N/A N/A  
Floating (Mat'l Spec. No.) Dia. Nom. thk. Corr. Allow. Attachment

13. Tubes: N/A N/A N/A N/A N/A  
Mat'l Spec. No., Grade or Type O. D. (Nom. thk.) Number Type (Straight or U)

*Items 14-18 incl. to be completed for inner chambers of jacketed vessels or channels of heat exchangers.*

14. Shell (a) No. of course(s): N/A (b) Overall length: N/A

Course(s)			Material	Thickness		Long. Joint (Cat. A)			Circum. Joint (Cat. A, B, & C)			Heat Treatment	
No.	Diameter	Length	Spec./Grade or Type	Nom.	Corr.	Type	Full, Spot, None	Eff.	Type	Full, Spot, None	Eff.	Temp.	Time
	<u>N/A</u>	<u>N/A</u>	<u>N/A</u>	<u>N/A</u>	<u>N/A</u>	<u>N/A</u>	<u>N/A</u>	<u>N/A</u>	<u>N/A</u>	<u>N/A</u>	<u>N/A</u>	<u>N/A</u>	<u>N/A</u>

15. Heads: (a) N/A (b) N/A  
(Mat'l Spec. No., Grade or Type) (H.T. - Time & Temp.) (Mat'l Spec. No., Grade or Type) (H.T. - Time & Temp.)

	Location (Top, Bottom, Ends)	Thickness		Radius		Elliptical Ratio	Conical Apex Angle	Hemispherical Radius	Flat Diameter	Side to Pressure		Category A		
		Min.	Corr.	Crown	Knuckle					Convex	Concave	Type	Full, Spot, None	Eff.
(a)	<u>N/A</u>	<u>N/A</u>	<u>N/A</u>	<u>N/A</u>	<u>N/A</u>	<u>N/A</u>	<u>N/A</u>	<u>N/A</u>	<u>N/A</u>			<u>N/A</u>	<u>N/A</u>	<u>N/A</u>

If removable, bolts used (describe other fastening) N/A  
(Mat'l, Spec. No., Grade, Size, No.)

S.O. 95021

SS 5-23-14

16. MAWP N/A N/A at max. temp. N/A N/A Min. design metal temp. N/A at N/A  
 (internal) (external) (internal) (external)

17. Impact test N/A at test temperature of N/A  
 (Indicate yes or no and the component(s) impact tested)

18. Hydro., pneu., or comb. test press. N/A Proof test N/A

19. Nozzles, inspection, and safety valve openings:

Purpose (Inlet, Outlet, Drain, etc.)	No.	Diameter or Size	Flange Type	Material		Nozzle Thickness		Reinforcement Material	How Attached		Location (Insp. Open.)
				Nozzle	Flange	Nom.	Corr.		Nozzle	Flange	
Inlet	2	2"	STUDS	SA193-B7		5/8"					
Outlet	2	2"	STUDS	SA193-B7		5/8"					

20. Supports: Skirt \_\_\_\_\_ Lugs N/A Legs N/A Others FEET Attached BOLTED  
 (Yes or no) (No.) (No.) (Describe) (Where and how)

21. Manufacturer's Partial Data Reports properly identified and signed by Commissioned Inspectors have been furnished for the following items of the report:  
N/A  
 (List the name of part, item number, mfg's. name and identifying number)

22. Remarks:  
Actual Plates (24) SA240-316 .02" (52)" Plates Maximum; Distance between Heads = 3.3096";  
Customer PO#: 41109; Tag #: ; Owner to supply Safety Valve/Noncorrosive Service Only

CERTIFICATE OF SHOP COMPLIANCE

We certify that the statements made in this report are correct and that all details of design, material, construction, and workmanship of this vessel conform to the ASME Code for Pressure Vessels, Section VIII, Division 1. U Certificate of Authorization No. 25017 Expires July 5, 2016

Date 05/16/2014 Name Alfa Laval Inc. Signed [Signature]  
 (Manufacturer) (Representative)

CERTIFICATE OF SHOP INSPECTION

I, the undersigned, holding a valid commission issued by The National Board of Boiler and Pressure Vessel Inspectors and/or the State or Province of VA and employed by OneCIS Insurance Company, of Lynn, MA have inspected the pressure vessel described in this Manufacturer's Data Report on May 12, 2014, and state that, to the best of my knowledge and belief, the Manufacturer has constructed this pressure vessel in accordance with ASME Code, Section VIII, Division 1. By signing this certificate neither the Inspector nor his employer makes any warranty, expressed or implied, concerning the pressure vessel described in this Manufacturer's Data Report. Furthermore, neither the Inspector nor his employer shall be liable in any manner for any personal injury or property damage or a loss of any kind arising from or connected with this inspection.

Date 05/16/2014 Signed [Signature] Commissions 10803A, VA951R  
 (Authorized Inspector) (Nat'l Board incl. endorsements, State, Province and No.)

CERTIFICATE OF FIELD ASSEMBLY COMPLIANCE

We certify that the statements made in this report are correct and that the field assembly construction of all parts of this vessel conforms with the requirements of ASME Code, Section VIII, Division 1. U Certificate of Authorization No. \_\_\_\_\_ Expires \_\_\_\_\_

Date \_\_\_\_\_ Name \_\_\_\_\_ Signed \_\_\_\_\_  
 (Assembler) (Representative)

CERTIFICATE OF FIELD ASSEMBLY INSPECTION

I, the undersigned, holding a valid commission issued by The National Board of Boiler and Pressure Vessel Inspectors and/or the State or Province of \_\_\_\_\_ and employed by \_\_\_\_\_ of \_\_\_\_\_ have compared the statements in this Manufacturer's Data Report with the described pressure vessel and state that parts referred to as data items \_\_\_\_\_, not included in the certificate of shop inspection, have been inspected by me and to the best of my knowledge and belief, the Manufacturer has constructed and assembled this pressure vessel in accordance with the ASME Code, Section VIII, Division 1. The described vessel was inspected and subjected to a hydrostatic test of \_\_\_\_\_ psi. By signing this certificate neither the Inspector nor his employer makes any warranty, expressed or implied, concerning the pressure vessel described in this Manufacturer's Data Report. Furthermore, neither the Inspector nor his employer shall be liable in any manner for any personal injury or property damage or a loss of any kind arising from or connected with this inspection.

Date \_\_\_\_\_ Signed \_\_\_\_\_ Commissions \_\_\_\_\_  
 (Authorized Inspector) (Nat'l Board incl. endorsements, State, Province and No.)



### Design Data Sheet

**Designation:** ..... Ucarsol Cooler - 1  
**Tag Number:** ..... E-11420-01  
**UE Unit:** ..... 114-1  
**Stockcode:** ..... B0084421

#### HEAT EXCHANGER SPECIFICATION:

**Duty:** ..... 231 kW [787,785 Btu/hr]  
**Surface Area:** ..... 23.3 m<sup>2</sup> [251.3 Ft<sup>2</sup>]  
**Design Code:** ..... ASME Section VIII, Div.1, Latest edition w/ U-Stamp  
**Seismic Design:** ..... UBC97/IBC Zone 3  
**Wind Load:** ..... 36 m/s ASCE 7-95, Exposure Cat. B  
**Tube Bundle:** ..... Removable  
**Design:** ..... TEMA class R – Refinery service  
**Surface Treatment:** ..... 100% pickled and passivated

#### TUBE SIDE:

**Media:** ..... Cooling Water  
**Flow:** ..... 28,016 kg/hr [61,764 lbs/hr]  
**Inlet Pressure:** ..... 2.55 Bara [37 Psia]  
**Inlet Temperature:** ..... 35.9°C [96.6°F]  
**Outlet Temperature:** ..... 43.0°C [109.4°F]  
**Passes per shell:** ..... 2  
**Design Pressure:** ..... 10.0 Barg [146 Psig]  
**Design Temperature:** ..... -29°C /160°C [-20°F /320°F]  
**Tube Diameter:** ..... 19 mm [3/4"]  
**Tube Quantity:** ..... 80  
**Connections:**  
    Inlet – Bottom ..... 3"-150#RF  
    Outlet – Top ..... 3"-150#RF

#### SHELL SIDE:

**Media:** ..... Lean Ucarsol Solution- 40%w  
**Liquid Inlet Flow:** ..... 9,430 kg/hr [20,783 lbs/hr]  
**Inlet Pressure:** ..... 34.7 Bara [503 Psia]  
**Inlet Temperature:** ..... 70.5°C [158.9°F]  
**Outlet Temperature:** ..... 47.3°C [117.1°F]  
**Design Pressure:** ..... 52.0 Barg [755 Psig]  
**Design Temperature:** ..... -29°C /160°C [-20°F /320°F]  
**Shell Diameter:** ..... 324mm [12-3/4"]  
**Connections:**  
    Liquid Inlet ..... 2"-600#RF  
    Liquid Outlet ..... 2"-600#RF

#### MATERIALS:

**Tubes, Tube-sheet, Shell:** ..... 304L Stainless steel  
**Bonnet:** ..... Carbon Steel  
**Gaskets:** ..... Spiral wound  
**Prohibited Materials (wetted parts):** ..... Aluminum, zinc, galv. metals, copper, Viton, BunaN




ITEM	QTY	DESCRIPTION
A	1	UCARSOL INLET: 2" NPS. (SCH.160) c/w 600 LB R.F.W.N. FLANGE
B	1	UCARSOL OUTLET: 2" NPS. (SCH.160) c/w 600 LB R.F.W.N. FLANGE
C	1	WATER INLET: 3" NPS. (SCH.40) c/w 150 LB R.F.S.O. FLANGE
D	1	WATER OUTLET: 3" NPS. (SCH.40) c/w 150 LB R.F.S.O. FLANGE
E	1	DRAIN CONN.: 3/4" FPT. 6000LB COUPLING

ITEM	QTY	DESCRIPTION
F	1	RELIEF: 3/4" FPT. 6000LB COUPLING
G	2	P.I.: 3/4" FPT. 6000LB THREADED O-LET
H	2	P.I.: 3/4" FPT. 6000LB COUPLING
J	1	NAMEPLATE: c/w 2" RAISED BRACKET
K	2	SADDLES: c/w 9/16" DIA. HOLES. (2 PER SADDLE)

ITEM	QTY	DESCRIPTION
L	2	LIFTING LUG: c/w 1" DIA. HOLE. (FOR HEAD ONLY)
M	2	LIFTING LUG: c/w 3" DIA. HOLE

For Record: 03-19-14 - Rev.3  
Approved (as-noted): 03-17-14 - Rev.2  
- S. Smith

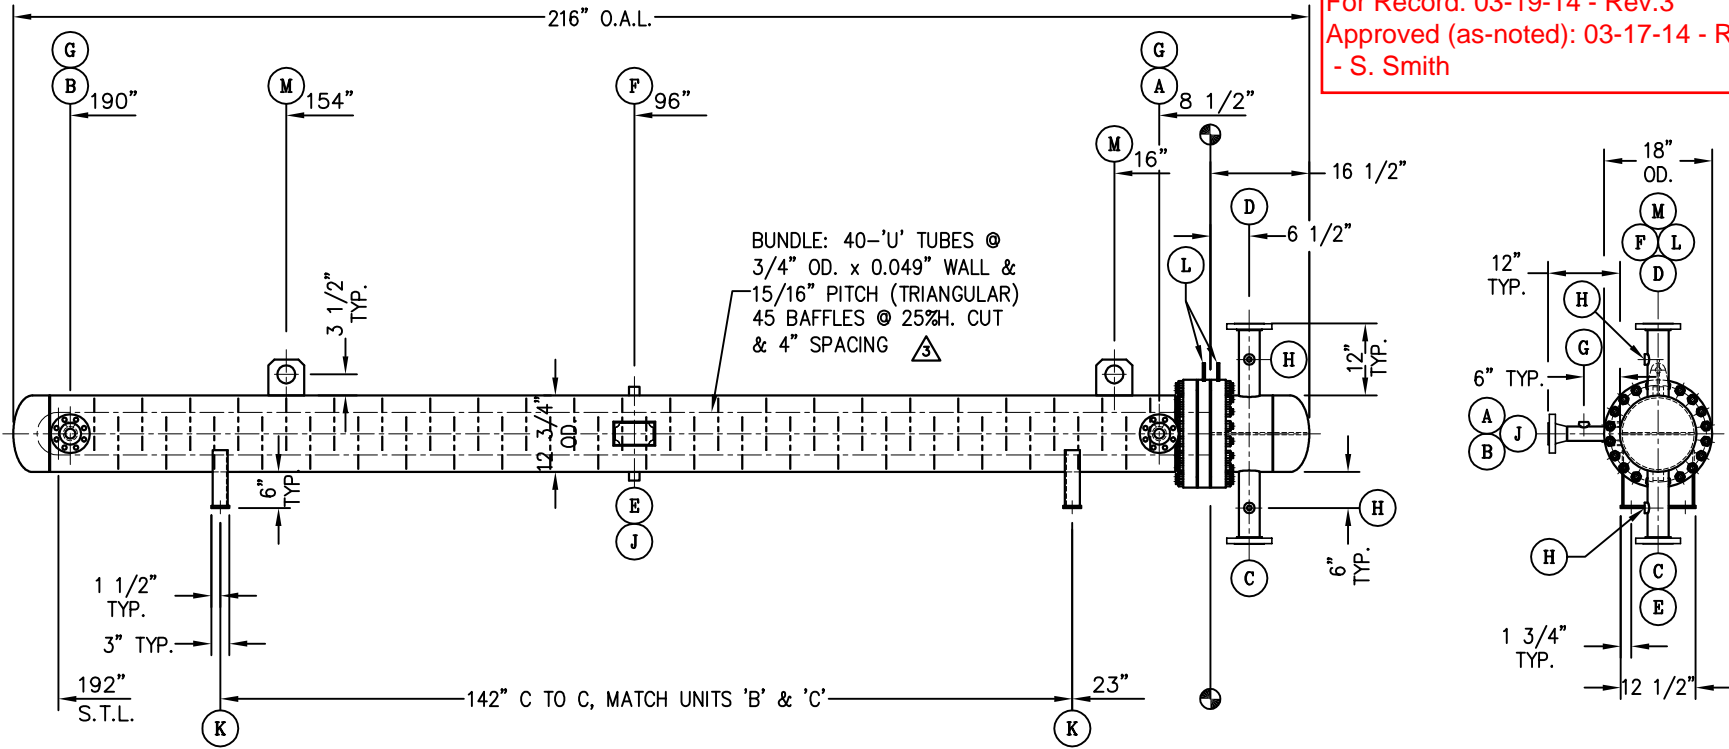

- NOTES**
- DO NOT SCALE DRAWING.
  - ALL DIMENSIONS ARE IN INCHES.
  - VESSEL TO BE DESIGNED & CONSTRUCTED IN ACCORDANCE WITH A.S.M.E. SECTION VIII, DIVISION 1, 2013 EDITION, UW-12(d)(e), C.S.A. B-51 CODES & TEMA class 'R'.
  - TAIL DIMENSIONS REFERENCED FROM DATUM LINE.
  - VESSEL TO BE CLEAN & FREE OF ALL DIRT & SCALE.
  - ALL EXPOSED INSIDE EDGES TO BE CHAMFERED OR ROUNDED.
  - EXTERIOR FINISH: ONE COAT GREY PAINT, (CARBON STEEL ONLY) ALL STAINLESS STEEL TO BE PICKLED AND PASSIVATED.
  - FLANGE BOLT HOLES TO STRADDLE VESSEL CENTERLINES.
  - TUBES TO BE SEAL WELDED TO TUBESHEETS.
  - CORROSION ALLOWANCE: SHELLSIDE=NIL, TUBESIDE=1/8".
  - RADIOGRAPHY: SPOT RT SHELL SIDE CIR. SEAM ONLY.
  - UW-50 APPLIES SHELL SIDE ONLY.
  - VESSEL TO HAVE A 'e'-DOCUMENTATION PACKAGE COMPLETED.
  - VESSEL TO BE SHIPPED c/w 5 PSIG. NITROGEN CHARGE.
  - VESSEL DESIGNED TO SEISMIC: UBC97, ZONE 3, WIND LOAD: 36m/s. ASCE7-95 EXP. CAT. B
  - UNIT TO BE PNEUMATICALLY TESTED IN ACCORDANCE WITH CODE CASE 1518-5.
  - REMOVABLE BUNDLE DESIGN. SPIRAL WOUND GASKETS.
  - TOLERANCES PER TEMA.

MATERIALS	
SHELLS : SA 312 TP304/L WLD -SHELL SA 53B ERW -CHANNEL	FLANGE RINGS : SA 240 304/L -SHELL SIDE SA 516 70 NORM. -TUBE SIDE
NOZZLES : SA 312 TP304/L WLD -SHELL SIDE SA 106B SMLS -TUBE SIDE	NOZZLE FLANGES : SA 182 F304/L -SHELL SIDE SA 105N -TUBE SIDE
TUBESHEETS : SA 240 304/L	BOLTING : SA 193-B8,CL2/SA 194-8
HEADS : SA 403 304/L WP-W -SHELL SIDE SA 234 WPB -TUBE SIDE	TUBES : SA 249 TP304/L WLD (PLAIN)
DESIGN CONDITIONS	
SHELL SIDE D.W.P. : 755 P.S.I.G. SHELL SIDE D.W.T. : -20F. / 320F. M.D.M.T. : -20F @ 755 PSIG.	TUBE SIDE D.W.P. : 146 P.S.I.G. TUBE SIDE D.W.T. : -20F. / 320F. M.D.M.T. : -20F @ 146 PSIG.
FLUID : LEAN UCARSOL	FLUID : WATER
TEMP. RANGE : 158.9°F. to 117.12°F.	TEMP. RANGE : 96.62°F. to 109.4°F
FLOW : 20,783 LB/HR	FLOW : 61,764 LB/HR
CAPACITY : 787,785 BTU/HR.	PRESSURE DROP : 1.36 P.S.I. -SHELL SIDE 1.39 P.S.I. -TUBE SIDE

UNION ENGINEERING LLC NORTH AMERICA  
PALM COAST, FL  
UE PROJECT: 00116

STOCK CODE: B0084421, TAG: E-11420-01  
EMPTY WEIGHT: 2,450 (LBS) QTY.:1

DATE	REV.	BY	DESCRIPTION	APP'D.
MAR. 17/14	3	PQ	ADDED BAFFLE & BUNDLE SPECIFICATIONS, REVISED LIFTING LUG HOLE LOCATION	
MAR. 13/14	2	PQ	NTL WAS 168", RELOCATED NOZZLES & SADDLES, REVISED WEIGHT REVISED PRESSURE DROP, REDESIGNED SADDLE	
FEB. 20/14	1	PQ	REVISED DESIGN CONDITIONS RELOCATED 'A' 'B', ADDED 'M', REVISED NOTE #17	

		P. O. BOX 1385, BRANTFORD, ONTARIO, CANADA, N3T 5T6 PHONE: (519) 759 3010 FAX: (519) 759 6746 or (519) 759 1611 WEB: www.HENRYTECH.ca	
		MODEL No.: LXXU-12192-210 UCARSOL COOLER	
CUSTOMER: UNION ENGINEERING N. AMERICA		CUSTOMER ORDER No.: 40999	
DATE: FEB. 10/14	BY: PQ	CHK'D:	APP'D:
SCALE: N.T.S.		ORDER NUMBER: C340059A	
REV. No.: 3			

FORM U-1 MANUFACTURER'S DATA REPORT FOR PRESSURE VESSELS

PO# 40999

As Required by the Provisions of the ASME Boiler and Pressure Vessel Code Rules, Section VIII, Division 1

1. Manufactured and certified by HENRY TECHNOLOGIES LIMITED, 36 CRAIG STREET, BRANTFORD, ONTARIO, CANADA, N3R 7J 1

(Name and address of Manufacturer)

2. Manufactured for UNION ENGINEERING NORTH AMERICA, 1 INDUSTRY DR., SUITE A, PALM COAST, FL 32137

(Name and address of Purchaser)

3. Location of installation UNKNOWN

(Name and address)

4. Type HORIZONTAL

(Horizontal, vertical, or sphere)

HEAT EXCHANGER

(Tank, separator, etc., vessel, heat exch., etc.)

C340059A-1

(Manufacturer's serial No.)

N/A

P340059A / 1

25625

2014

(CRN)

(Drawing number)

(National Board number)

(Year built)

5. ASME Code, Section VIII, Div.1

2013 EDITION -

1518-5 (Tubeside only)

[Edition and Addenda, if applicable (date)]

(Code Case number)

[Special Service per UG-120(d)]

Items 6-11 incl. to be completed for single wall vessels, jackets of jacketed vessels, shell of heat exchanger, or chamber of multichamber vessels.

6. Shell: (a) Number of course(s) 1

(b) Overall length 187.8125"

Table with columns: Course(s), Material, Thickness, Long Joint (Cat. A), Circum. Joint (Cat. A, B & C), Heat Treatment. Row 1: 1, 12.75" O.D., 187.8125", SA 312 TP304/L, 0.5", NIL, SMLS, NONE, 100%, B-1, NONE, 70%, -, -.

Body Flanges on Shells

Table with columns: No., Type, ID, OD, Flange Thk, Min Hub Thk, Material, How Attached, Location, Bolting (Num & Size, Bolting Material, Washer (OD, ID, thk), Washer Material). Row 1: 1, CUSTOM WN, 11.75", 18", 3.25", 0.4688", SA 182 F304/L, WELDED, END, 20-7/8"-9UNC, SA 193 B8, CL.2, -, -.

7. Heads: (a)

SA 403-304/L WP-W

(b)

(Material spec. number, grade or type) (H.T. - time and temp.)

(Material spec. number, grade or type) (H.T. - time and temp.)

Table with columns: Location (Top, Bottom, Ends), Thickness (Min., Corr.), Radius (Crown, Knuckle), Elliptical Ratio, Conical Apex Angle, Hemispherical Radius, Flat Diameter, Side to Pressure (Convex, Concave), Category A (Type, Full, Spot, None, Eff.). Row 1: END, 0.4375", NIL, -, -, 2:1, -, -, -, -, YES, -, -, -.

Body Flanges on Heads

Table with columns: Location, Type, ID, OD, Flange Thk, Min Hub Thk, Material, How Attached, Bolting (Num & Size, Bolting Material, Washer (OD, ID, thk), Washer Material). Row 1: -, -, -, -, -, -, -, -, -, -, -, -, -.

8. Type of jacket

Jacket closure

(Describe as ogee and weld, bar, etc.)

If bar, give dimensions

If bolted, describe or sketch.

9. MAWP 755 psi at max. temp. 320 °F Min. design metal temp. -20 °F at 755 psi

10. Impact test NO - AS PER UHA-51(d) at test temperature of °F

[Indicate yes or no and the component(s) impact tested]

11. PNEU test pressure 885 PSIG proof test

Items 12 and 13 to be completed for tube sections.

12. Tubesheet SA 240 304/L 12" 2" NIL WELDED
13. Tubes SA 249 TP 304/L WLD 0.75" 0.049" 40 U



### Design Data Sheet

**Designation:** ..... Ucarsol Cooler - 2  
**Tag Number:** ..... E-11420-02  
**UE Unit:** ..... 114-1  
**Stockcode:** ..... B0084422

**HEAT EXCHANGER SPECIFICATION:**

**Duty:** ..... 94.2 kW [321,772 Btu/hr]  
**Surface Area:** ..... 23.3 m<sup>2</sup> [251.3 Ft<sup>2</sup>]  
**Design Code:** ..... ASME Section VIII, Div.1, Latest edition w/ U-Stamp  
**Seismic Design:** ..... UBC97/IBC Zone 3  
**Wind Load:** ..... 36 m/s ASCE 7-95, Exposure Cat. B  
**Tube Bundle:** ..... Removable  
**Design:** ..... TEMA class R – Refinery service  
**Surface Treatment:** ..... 100% pickled and passivated

**TUBE SIDE:**

**Media:** ..... Cooling Water  
**Flow:** ..... 28,016 kg/hr [61,764 lbs/hr]  
**Inlet Pressure:** ..... 2.55 Bara [37 Psia]  
**Inlet Temperature:** ..... 33.0°C [91.4°F]  
**Outlet Temperature:** ..... 35.9°C [96.6°F]  
**Passes per shell:** ..... 2  
**Design Pressure:** ..... 10.0 Barg [146 Psig]  
**Design Temperature:** ..... -29°C /160°C [-20°F /320°F]  
**Tube Diameter:** ..... 19 mm [3/4"]  
**Tube Quantity:** ..... 80  
**Connections:**  
    **Inlet – Bottom** ..... 3" -150#RF  
    **Outlet – Top** ..... 3" -150#RF

**SHELL SIDE:**

**Media:** ..... Lean Ucarsol Solution- 40%w  
**Liquid Inlet Flow:** ..... 9,430 kg/hr [20,783 lbs/hr]  
**Inlet Pressure:** ..... 34.7 Bara [503 Psia]  
**Inlet Temperature:** ..... 47.3°C [117.1°F]  
**Outlet Temperature:** ..... 38.0°C [100.4°F]  
**Design Pressure:** ..... 52.0 Barg [755 Psig]  
**Design Temperature:** ..... -29°C /160°C [-20°F /320°F]  
**Shell Diameter:** ..... 324mm [12-3/4"]  
**Connections:**  
    **Liquid Inlet** ..... 2" -600#RF  
    **Liquid Outlet** ..... 2" -600#RF

**MATERIALS:**


**Tubes, Tube-sheet, Shell:** ..... 304L Stainless steel  
**Bonnet:** ..... Carbon Steel  
**Gaskets:** ..... Spiral wound  
**Prohibited Materials (wetted parts):** ..... Aluminum, zinc, galv. metals, copper, Viton, BunaN

ITEM	QTY	DESCRIPTION
A	1	UCARSOL INLET: 2" NPS. (SCH.160) c/w 600 LB R.F.W.N. FLANGE
B	1	UCARSOL OUTLET: 2" NPS. (SCH.160) c/w 600 LB R.F.W.N. FLANGE
C	1	WATER INLET: 3" NPS. (SCH.40) c/w 150 LB R.F.S.O. FLANGE
D	1	WATER OUTLET: 3" NPS. (SCH.40) c/w 150 LB R.F.S.O. FLANGE
E	1	DRAIN CONN.: 3/4" FPT. 6000LB COUPLING

ITEM	QTY	DESCRIPTION
F	1	RELIEF: 3/4" FPT. 6000LB COUPLING
G	2	P.I.: 3/4" FPT. 6000LB THREADED O-LET
H	2	P.I.: 3/4" FPT. 6000LB COUPLING
J	1	NAMEPLATE: c/w 2" RAISED BRACKET
K	2	SADDLES: c/w 9/16" DIA. HOLES. (2 PER SADDLE)

ITEM	QTY	DESCRIPTION
L	2	LIFTING LUG: c/w 1" DIA. HOLE. (FOR HEAD ONLY)
M	2	LIFTING LUG: c/w 3" DIA. HOLE

For Record: 03-19-14 - Rev.3  
Approved (as-noted): 03-17-14 - Rev.2  
- S. Smith

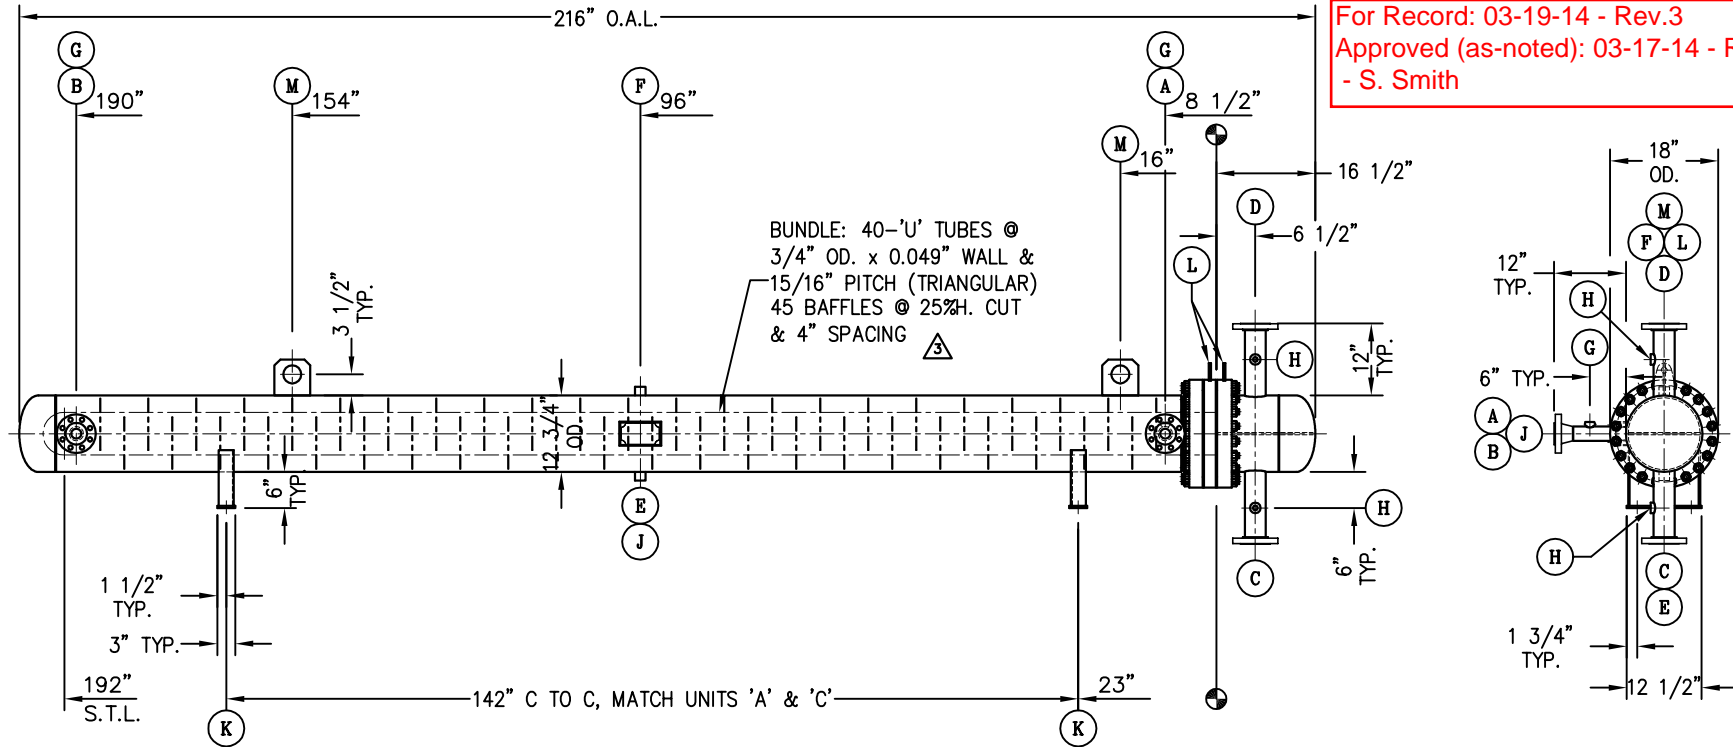

- NOTES**
- DO NOT SCALE DRAWING.
  - ALL DIMENSIONS ARE IN INCHES.
  - VESSEL TO BE DESIGNED & CONSTRUCTED IN ACCORDANCE WITH A.S.M.E. SECTION VIII, DIVISION 1, 2013 EDITION, UW-12(d)(e), C.S.A. B-51 CODES & TEMA class 'R'.
  - TAIL DIMENSIONS REFERENCED FROM DATUM LINE.
  - VESSEL TO BE CLEAN & FREE OF ALL DIRT & SCALE.
  - ALL EXPOSED INSIDE EDGES TO BE CHAMFERED OR ROUNDED.
  - EXTERIOR FINISH: ONE COAT GREY PAINT, (CARBON STEEL ONLY) ALL STAINLESS STEEL TO BE PICKLED AND PASSIVATED.
  - FLANGE BOLT HOLES TO STRADDLE VESSEL CENTERLINES.
  - TUBES TO BE SEAL WELDED TO TUBESHEETS.
  - CORROSION ALLOWANCE: SHELLSIDE=NIL, TUBESIDE=1/8".
  - RADIOGRAPHY: SPOT RT SHELL SIDE CIR. SEAM ONLY.
  - UW-50 APPLIES SHELL SIDE ONLY.
  - VESSEL TO HAVE A 'e'-DOCUMENTATION PACKAGE COMPLETED.
  - VESSEL TO BE SHIPPED c/w 5 PSIG. NITROGEN CHARGE.
  - VESSEL DESIGNED TO SEISMIC: UBC97, ZONE 3, WIND LOAD: 36m/s. ASCE7-95 EXP. CAT. B
  - UNIT TO BE PNEUMATICALLY TESTED IN ACCORDANCE WITH CODE CASE 1518-5.
  - REMOVABLE BUNDLE DESIGN. c/w SPIRAL WOUND GASKETS.
  - TOLERANCES PER TEMA.

MATERIALS	
SHELLS : SA 312 TP304/L WLD -SHELL	FLANGE RINGS : SA 240 304/L -SHELL SIDE
SA 53B ERW -CHANNEL	SA 516 70 NORM. -TUBE SIDE
NOZZLES : SA 312 TP304/L WLD -SHELL SIDE	NOZZLE FLANGES : SA 182 F304/L -SHELL SIDE
SA 106B SMLS -TUBE SIDE	SA 105N -TUBE SIDE
TUBESHEETS : SA 240 304/L	BOLTING : SA 193-B8,CL.2/SA 194-8
HEADS : SA 403 304/L WP-W -SHELL SIDE	TUBES : SA 249 TP304/L WLD (PLAIN)
SA 234 WPB -TUBE SIDE	
DESIGN CONDITIONS	
SHELL SIDE D.W.P. : 755 P.S.I.G.	TUBE SIDE D.W.P. : 146 P.S.I.G.
SHELL SIDE D.W.T. : -20F. / 320F.	TUBE SIDE D.W.T. : -20F. / 320F.
M.D.M.T. : -20F @ 755 PSIG.	M.D.M.T. : -20F @ 146 PSIG.
FLUID : LEAN UCARSOL	FLUID : WATER
TEMP. RANGE : 117.12°F. to 100.4°F.	TEMP. RANGE : 91.4°F. to 96.62°F
FLOW : 20,783 LB/HR	FLOW : 61,764 LB/HR
CAPACITY : 321,772 BTU/HR.	PRESSURE DROP : 1.38 P.S.I. -SHELL SIDE 1.44 P.S.I. -TUBE SIDE

UNION ENGINEERING LLC NORTH AMERICA  
PALM COAST, FL  
UE PROJECT: 00116

STOCK CODE: B0084422, TAG: E-11420-02  
EMPTY WEIGHT: 2,450 (LBS) QTY.:1

DATE	REV.	BY	DESCRIPTION	APP'D.
MAR. 17/14	3	PQ	ADDED BAFFLE & BUNDLE SPECIFICATIONS, REVISED LIFTING LUG HOLE LOCATION	
MAR. 13/14	2	PQ	NTL WAS 168", RELOCATED NOZZLES & SADDLES, REVISED WEIGHT REVISED PRESSURE DROP, REDESIGNED SADDLE	
FEB. 20/14	1	PQ	REVISED DESIGN CONDITIONS RELOCATED 'A' 'B', ADDED 'M', REVISED NOTE #17	

P. O. BOX 1385, BRANTFORD, ONTARIO, CANADA, N3T 5T6  
PHONE: (519) 759 3010  
FAX: (519) 759 6746 or (519) 759 1611  
WEB: www.HENRYTECH.ca

MODEL No.: LXXU-12192-210 UCARSOL COOLER

CUSTOMER: UNION ENGINEERING N. AMERICA CUSTOMER ORDER No.: 40999

DATE: FEB. 10/14	BY: PQ	CHK'D:	APP'D:	SCALE: N.T.S.	ORDER NUMBER: C340059B	REV. No.: 3
------------------	--------	--------	--------	---------------	------------------------	-------------

FORM U-1 MANUFACTURER'S DATA REPORT FOR PRESSURE VESSELS

PO# 40999

As Required by the Provisions of the ASME Boiler and Pressure Vessel Code Rules, Section VIII, Division 1

- 1. Manufactured and certified by HENRY TECHNOLOGIES LIMITED, 36 CRAIG STREET, BRANTFORD, ONTARIO, CANADA, N3R 7J 1  
(Name and address of Manufacturer)
- 2. Manufactured for UNION ENGINEERING NORTH AMERICA, 1 INDUSTRY DR., SUITE A, PALM COAST, FL 32137  
(Name and address of Purchaser)
- 3. Location of installation UNKNOWN  
(Name and address)
- 4. Type HORIZONTAL HEAT EXCHANGER C340059B-1  
(Horizontal, vertical, or sphere) (Tank, separator, jkt. vessel, heat exch., etc.) (Manufacturer's serial No.)  
N/A P340059B / 1 25626 2014  
(CRN) (Drawing number) (National Board number) (Year built)
- 5. ASME Code, Section VIII, Div. 1 2013 EDITION - 1518-5 (Tubeside only) -  
(Edition and Addenda, if applicable (date)) (Code Case number) [Special Service per UG-120(d)]

Items 6-11 incl. to be completed for single wall vessels, jackets of jacketed vessels, shell of heat exchanger, or chamber of multichamber vessels.

- 6. Shell: (a) Number of course(s) 1 (b) Overall length 187.8125"

Course(s)			Material	Thickness		Long Joint (Cat. A)			Circum. Joint (Cat. A,B & C)			Heat Treatment	
No.	Diameter	Length	Spec./Grade or Type	Nom.	Corr.	Type	Full,Spot,Non e	Eff.	Type	Full,Spot,Non e	Eff.	Temp.	Time
1	12.75" O.D.	187.8125"	SA 312 TP304/L	0.5"	NIL	SMLS	NONE	100%	B-1	NONE	70%	-	-
-	-	-	-	-	-	-	-	-	-	-	-	-	-
-	-	-	-	-	-	-	-	-	-	-	-	-	-

Body Flanges on Shells													
No.	Type	ID	OD	Flange Thk	Min Hub Thk	Material	How Attached	Location	Bolting				
									Num & Size	Bolting Material	Washer (OD, ID, thk)	Washer Material	
1	CUSTOM WN	11.75"	18"	3.25"	0.4688"	SA 182 F304/L	WELDED	END	20-7/8"-9UNC	SA 193 B8,CL.2	-	-	-
-	-	-	-	-	-	-	-	-	-	-	-	-	-
-	-	-	-	-	-	-	-	-	-	-	-	-	-
-	-	-	-	-	-	-	-	-	-	-	-	-	-

- 7. Heads: (a) SA 403-304/L WP-W (Material spec. number, grade or type) (H.T. - time and temp.) (b) - (Material spec. number, grade or type) (H.T. - time and temp.)

Location (Top, Bottom, Ends)	Thickness		Radius		Elliptical Ratio	Conical Apex Angle	Hemispherical Radius	Flat Diameter	Side to Pressure		Category A		
	Min.	Corr.	Crown	Knuckle					Convex	Concave	Type	Full,Spot,Non e	Eff.
END	0.4375"	NIL	-	-	2:1	-	-	-	-	YES	-	-	-
-	-	-	-	-	-	-	-	-	-	-	-	-	-

Body Flanges on Heads													
Location	Type	ID	OD	Flange Thk	Min Hub Thk	Material	How Attached	Bolting					
								Num & Size	Bolting Material	Washer (OD, ID, thk)	Washer Material		
-	-	-	-	-	-	-	-	-	-	-	-	-	-
-	-	-	-	-	-	-	-	-	-	-	-	-	-

- 8. Type of jacket - Jacket closure (Describe as ogee and weld, bar, etc.)

If bar, give dimensions If bolted, describe or sketch.

- 9. MAWP 755 - psi at max. temp. 320 - °F Min. design metal temp. -20 °F at 755 psi  
(Internal) (External) (Internal) (External)


- 10. Impact test NO - AS PER UHA-5 1(d) at test temperature of - °F  
(Indicate yes or no and the component(s) impact tested)

- 11. PNEU test pressure 885 PSIG proof test

Items 12 and 13 to be completed for tube sections.

- 12. Tubesheet SA 240 304/L 12" 2" NIL WELDED  
(Stationary (material spec. no.)) (Diameter (subject to press.)) (Nominal thickness) (Corr. allow.) (Attachment (welded or bolted))  
[Floating (material spec. no.)) (Diameter) (Nominal thickness) (Corr. allow.) (Attachment)
- 13. Tubes SA 249 TP 304/L W LD 0.75" 0.049" 40 U  
(Material spec. no. grade or type) (O.D.) (Nominal thickness) (Number) [Type (straight or U)]






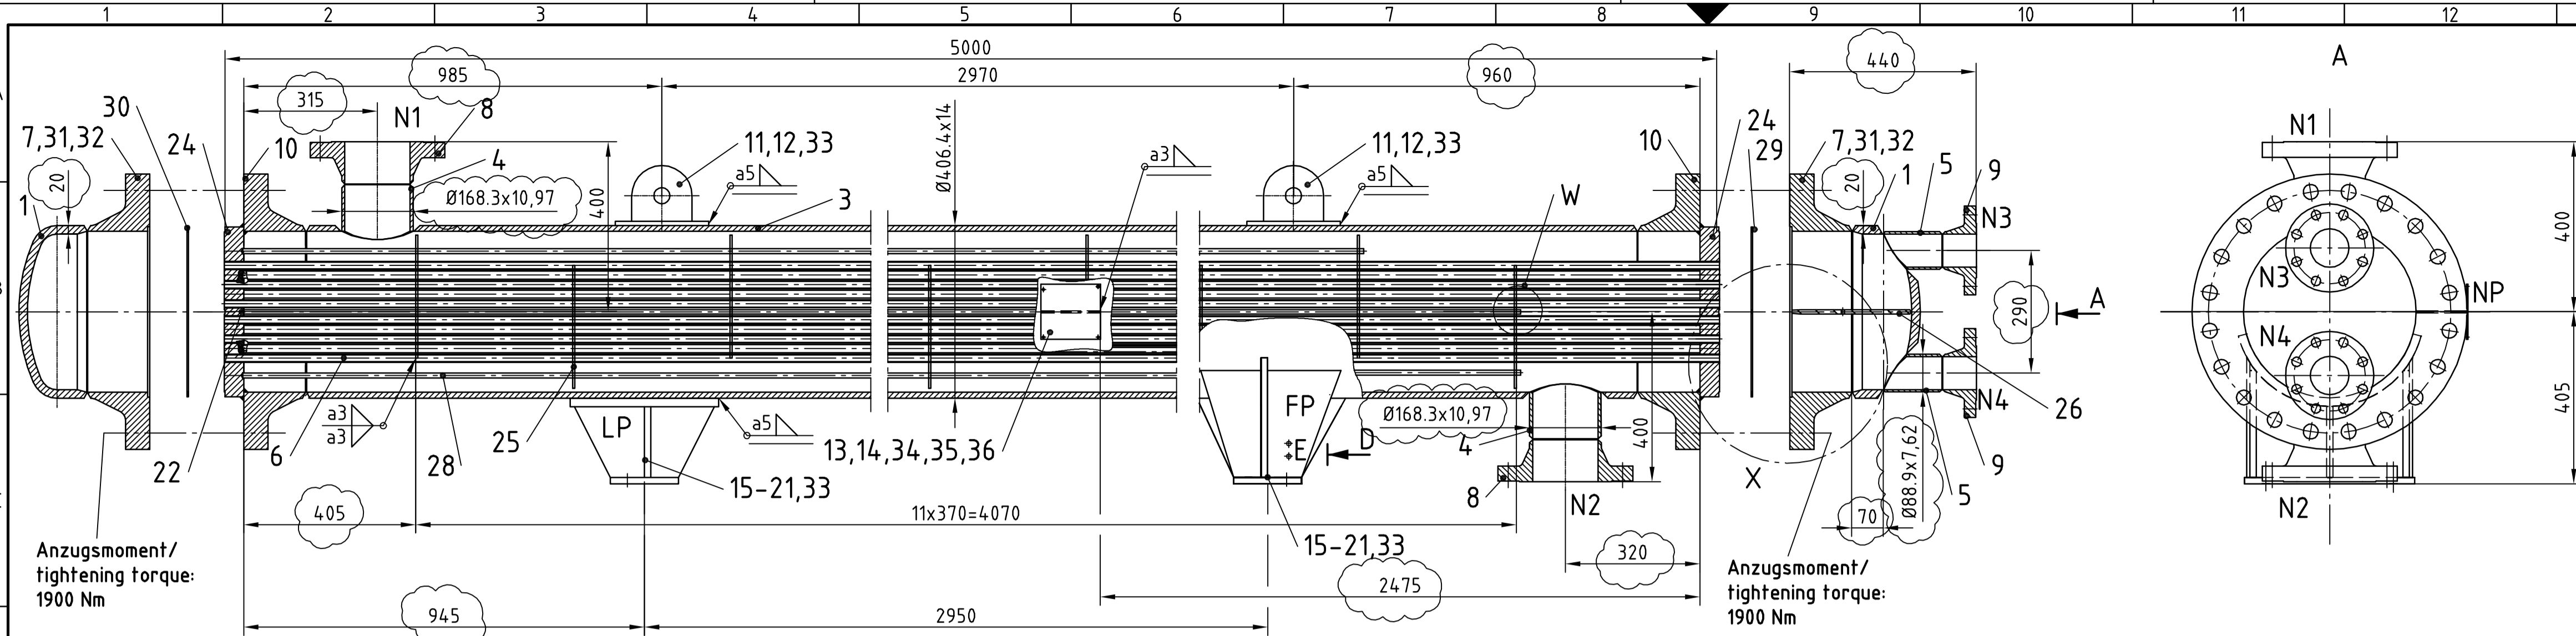

**VERSANDVORBEREITUNG / PREPARATIONS FOR SHIPMENT**  
 ALLE DRUCKRÄUME SIND NACH DER WASSERDRUCKPRÜFUNG RESTLOS ZU ENTLERN UND ZU SÄUBERN.  
 ALLE ÖFFNUNGEN SIND STAUB- UND SPRITZWASSERDICHT ZU VERSCHLIESSEN.  
 AFTER HYDROSTATIC PRESSURE TEST ALL SPACES SUBJECT TO PRESSURE SHALL BE ENTIRELY EMPTY AND CLEANED.  
 ALL OPENINGS ARE TO BE SEALED DUST AND SPLASH WATER TIGHT.




**OBERFLÄCHENBEHANDLUNG / PROTECTIVE COATING**  
**EDELSTAHL / SS:**  
 ALLE OBERFLÄCHEN SIND METAL. SAUBER. ZUNDER, ANLAUFFARBEN UND RESTE VON SCHWEISSSCHLACKEN SIND MECHANISCH ODER CHEMISCH ZU ENTFERNEN. BEIZEN UND PASSIVIEREN.  
 ALL SURFACES ARE METALLIC CLEAN. SCALE, ANNEALING COLOURS AND RESIDUES OF WELDING SLAG SHALL BE REMOVED MECHANICALLY OR CHEMICALLY. PICKLING AND PASSIVATION.

**C-STAHLE / CS:**  
**- MEDIUMSEITIG / ON MEDIUM SIDE**  
 VORSCHRIFT / REGULATION :  
 C-STAHLE / CS :  
**- AUSSENSEITIG / OUTSIDE**  
 VORSCHRIFT / REGULATION :  
 C-STAHLE / CS : ENTROSTEN / UNRUSTING : Sandstrahlen Sa 2,5 nach DIN EN ISO 12944-4 / sandblasting Sa 2 1/2 acc. to DIN EN ISO 12944-4  
 GRUNDIERUNG / PRIMER : 1x inorganic zinc coating TSD 75...125 µm, 1x epoxy coating TSD 125...200 µm  
 DECKSCHICHT / FINISH : 1x polyurethane TSD 50 µm

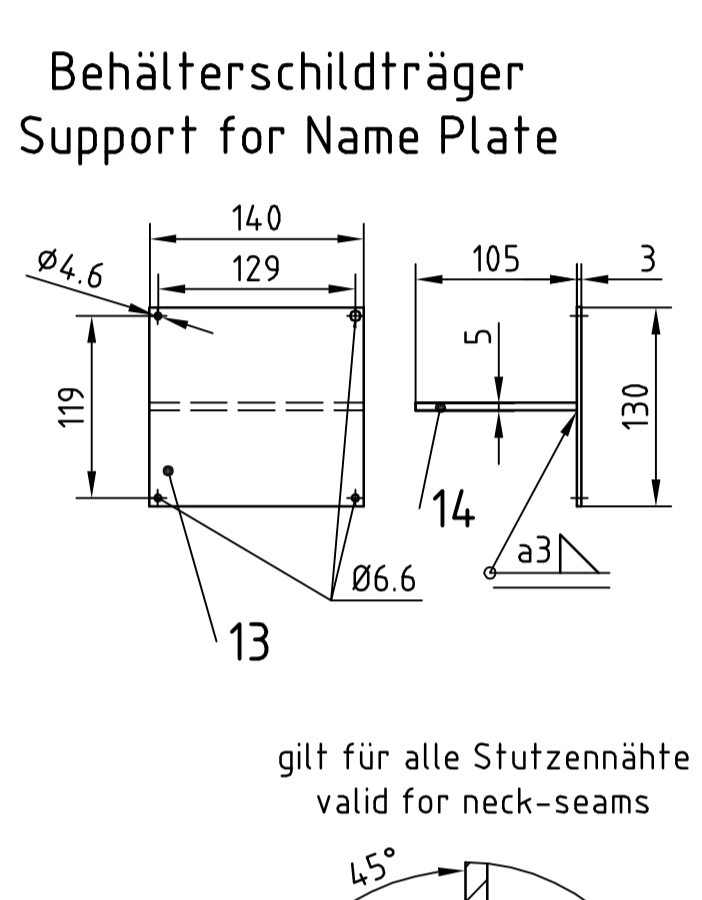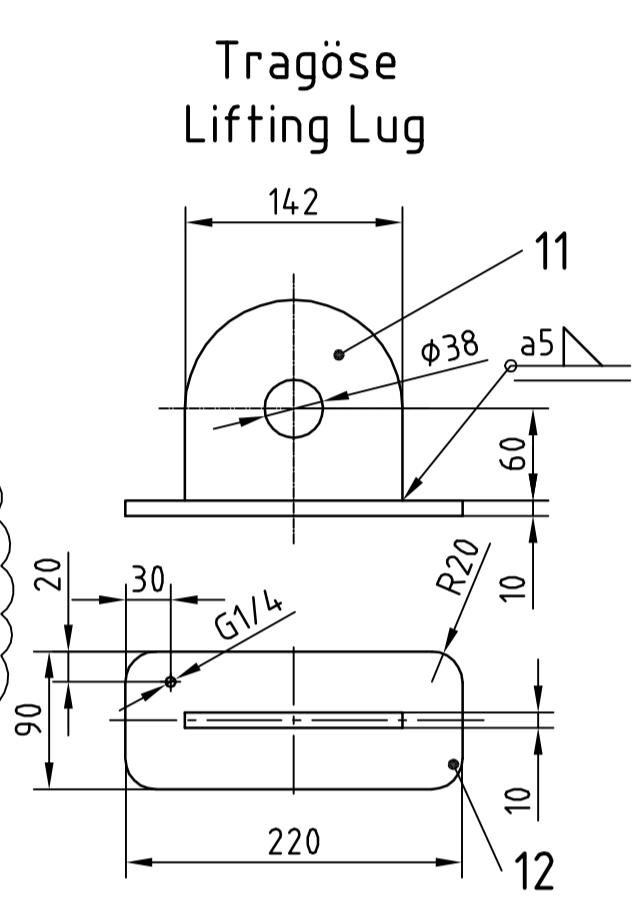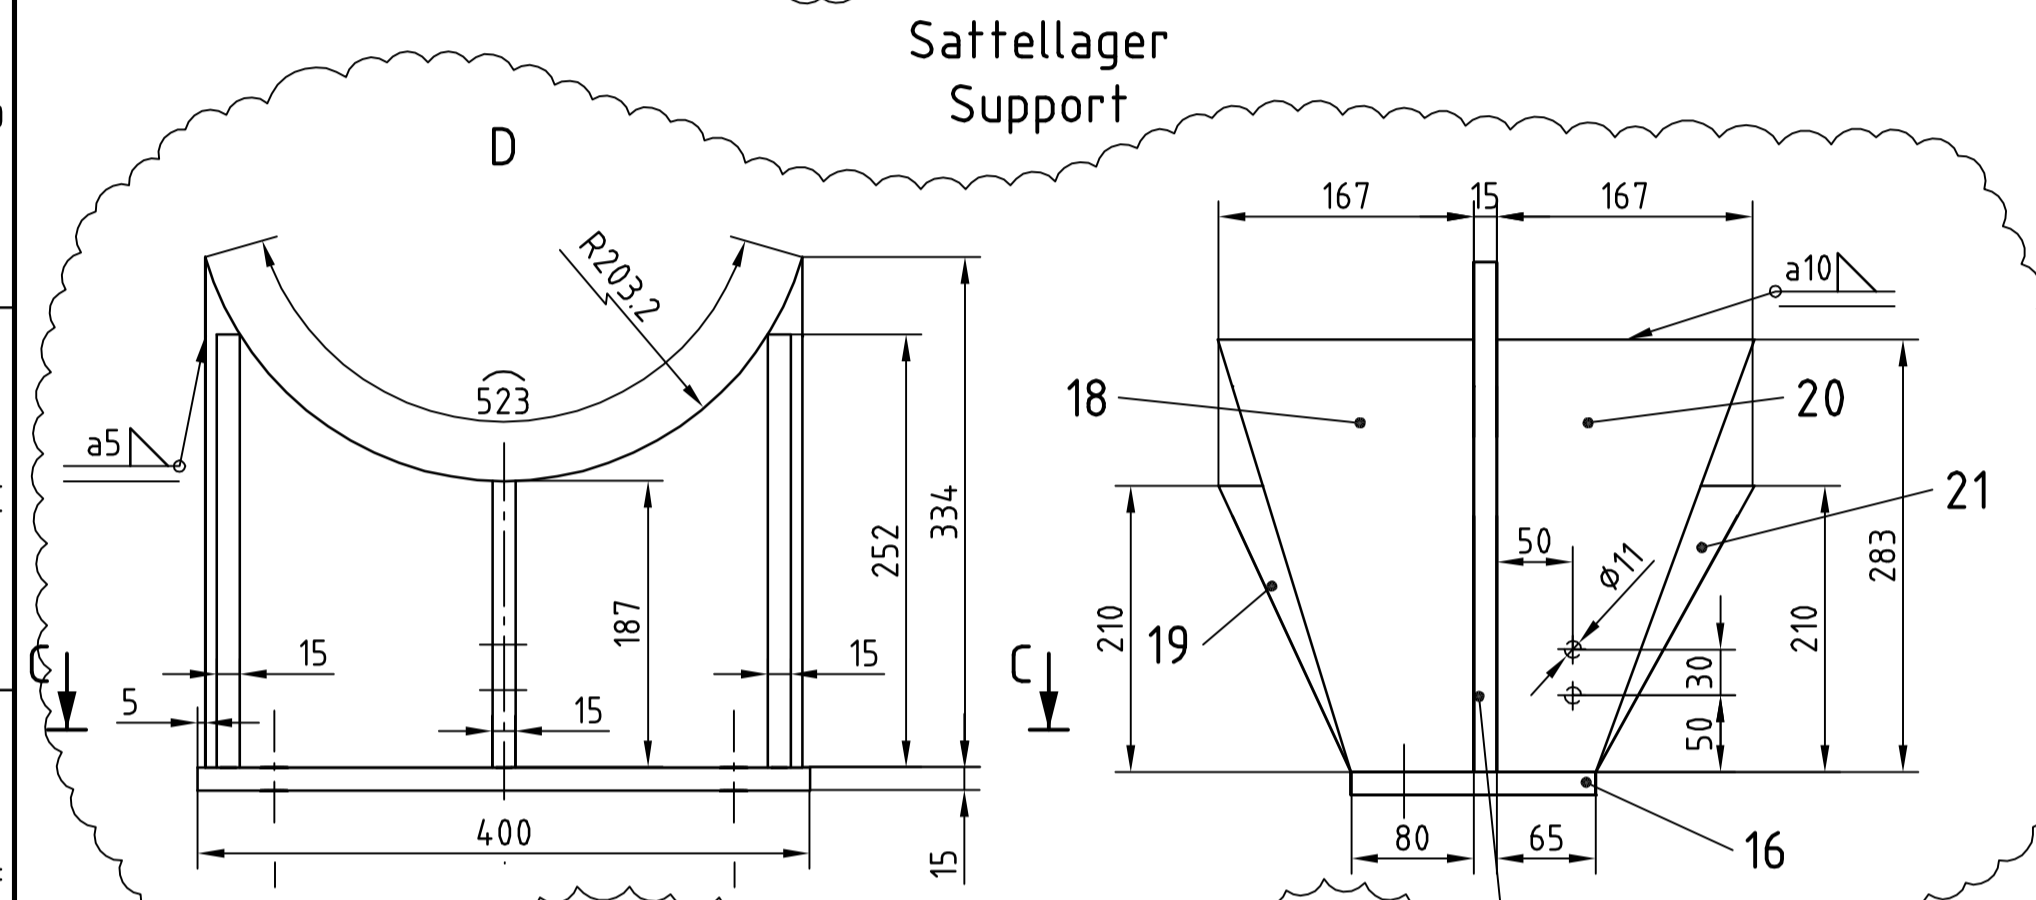

**Stützenlast - Angaben / Nozzle Loads**

Stützen Nozzle	DN NPS	P	N	Nm
		VL V1	VC V2	ML M1 MC M2
N1	6"	6700	6800	4800
N2	6"	6700	6800	4800
N3	3"	3500	4100	3000
N4	3"	3500	4100	3000

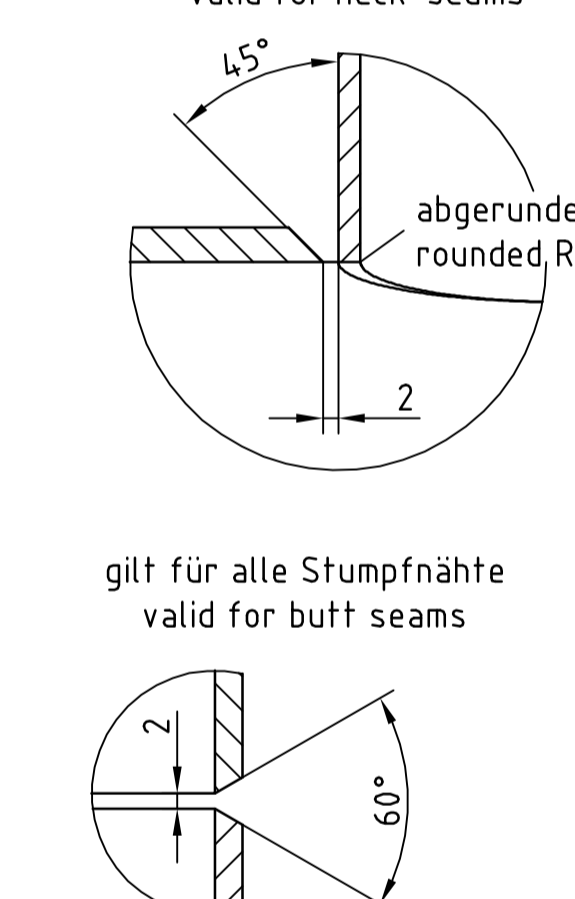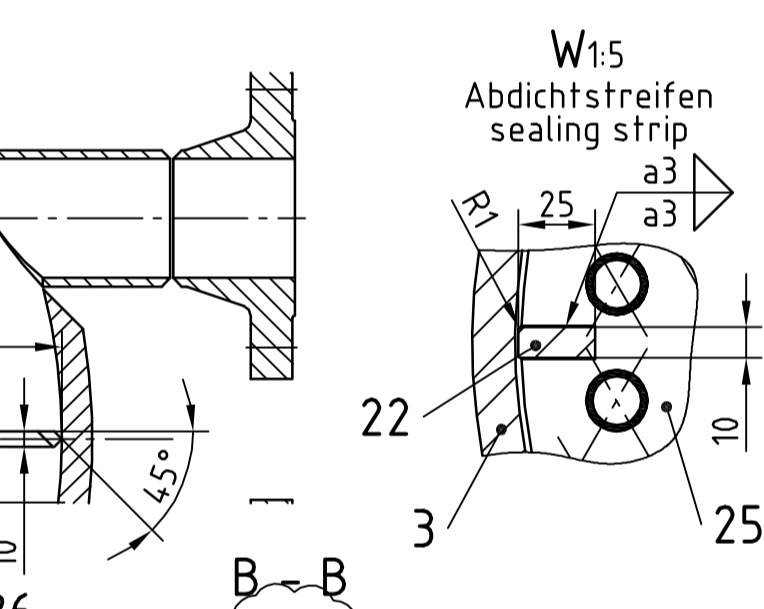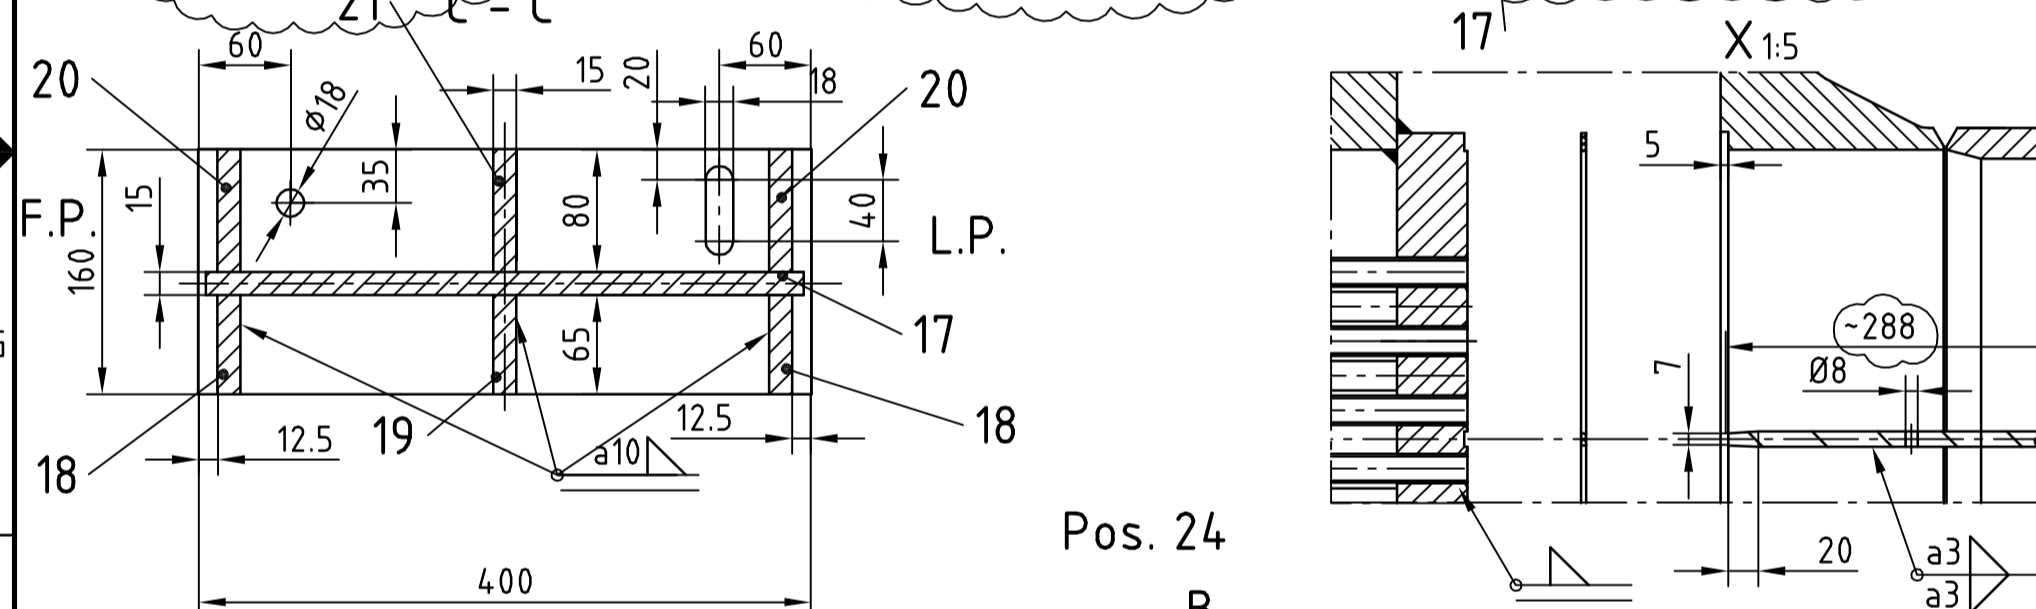

**Pos. 36**

Silica Verfahrenstechnik GmbH  
 Berlin, Germany

HERSTELLER MANUFACTURER: Silica Verfahrenstechnik GmbH, Wiltstr. 24, D-13509 Berlin

FABRIK NR. SERIAL NO.: 13755

BAUJAHR/YEAR OF CONSTRUCTION: 2014

	MANTELRAUM SHELL SPACE	ROHRAUM TUBE SPACE
HÖCHSTZUL. BETRIEBSÜBERDRUCK MAX. ALLOW. WORKING GAUGE PRESSURE	37	37
HÖCHSTZUL. BETRIEBSTEMPERATUR MAX. ALLOW. WORKING TEMPERATURE	120	120
INHALT VOLUME	465	78
PRODUKTGRUPPE FLUID GROUP	-	-

INHALT VOLUME: 465 l

LEERGewicht WEIGHT EMPTY: 2110 kg

BETRIEBSGewicht OPERATING WEIGHT: 2205 kg

ASME VIII Div.1

Objektart TYPE OF VESSEL: Precooler




Code: 02204-E-01

**TRANSPORTMAßE / DIMENSION FOR TRANSPORTATION: 6,4 m / 0,7 m / 0,8 m (L / B / H)**

GEWICHTE / WEIGHTS	BETRIEBSGewicht CA.	MIT WASSERFÜLLUNG CA.
TRANSPORTGEWICHT CA. LEERGewicht	2110 kg	2205 kg
TRANSPORTGEWICHT WITH FILLING	2205 kg	2575 kg

**TOLERANZEN UND OBERFLÄCHEN / TOLERANCES AND SURFACES**

MAßE OHNE TOLERANZANGABEN DIMENSIONS WITHOUT TOLERANCES	OBERFLÄCHENZEICHEN / SURFACE SYMBOLS	ZUGEHÖRIGE UNTERLAGEN SCHWEIß- UND PRÜFPLAN / WELDING AND TESTING PLAN
ALLGEMEIN / GENERAL: DIN ISO 2768-m	SYMBOL: DIN EN ISO 1302 (Rz in µm), DIN EN ISO 1302 (Ra in µm), DIN 3141 RHE/SERE-1 (veraltet)	SCHWEIß- UND PRÜFPLAN / WELDING AND TESTING PLAN ZCHNG.-NR. / DRWG. NO.:
SCHWEISSTEILE / WELDING PARTS: DIN EN ISO 13920	✓ = √Rz160 = √Ra25 = ∇	RONTGENPLAN / X RAYING PLAN ZCHNG.-NR. / DRWG. NO.:
BEHALTER / VESSEL: DIN 28005	✓ = √Rz40 = √Ra6,3 = ∇∇	FESTIGKEITSBERECHNUNG / CALCULATION OF STRENGTH ZCHNG.-NR. / DRWG. NO.:
WÄRMETAUSCHER / HEAT EXCHANGER: DIN 28008	✓ = √Rz16 = √Ra1,6 = ∇∇∇	

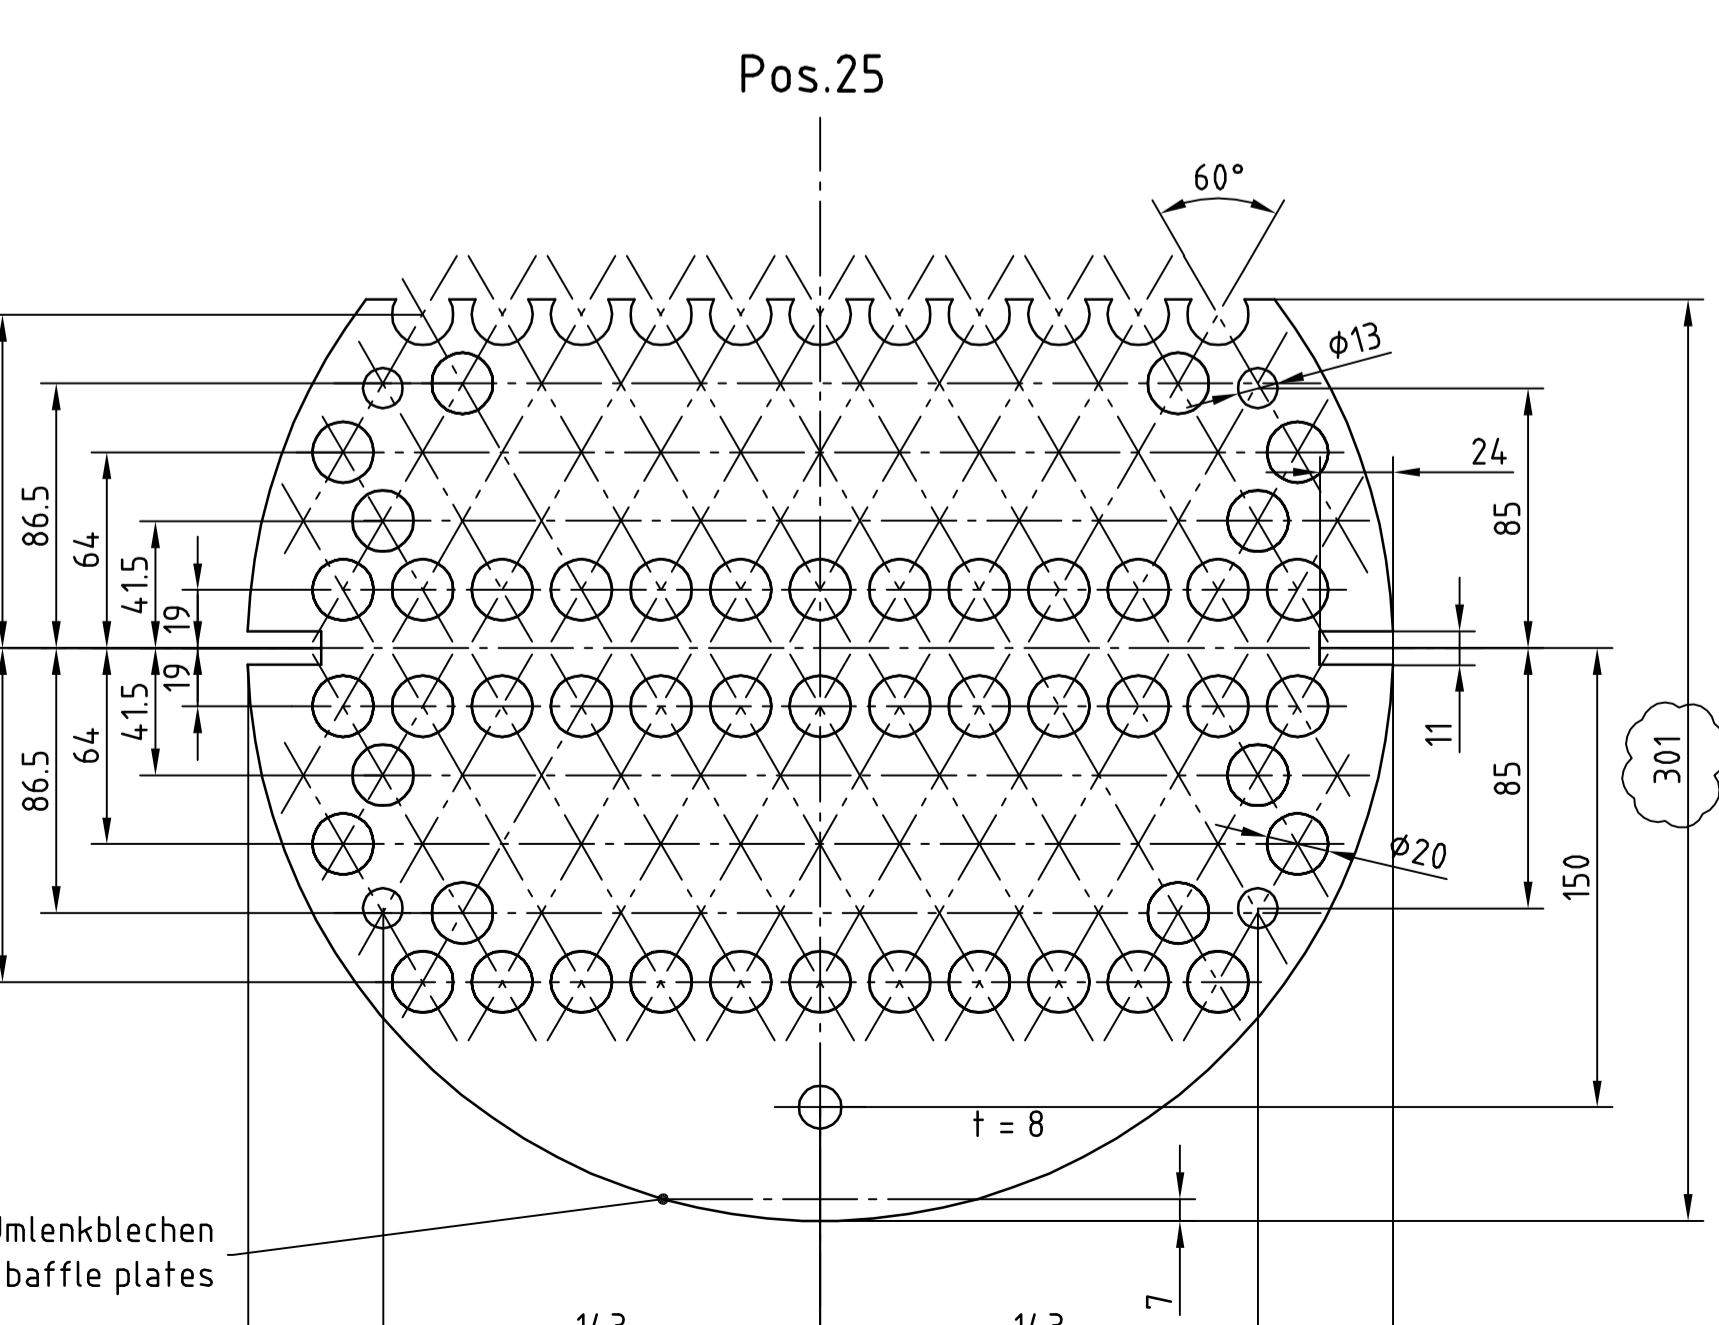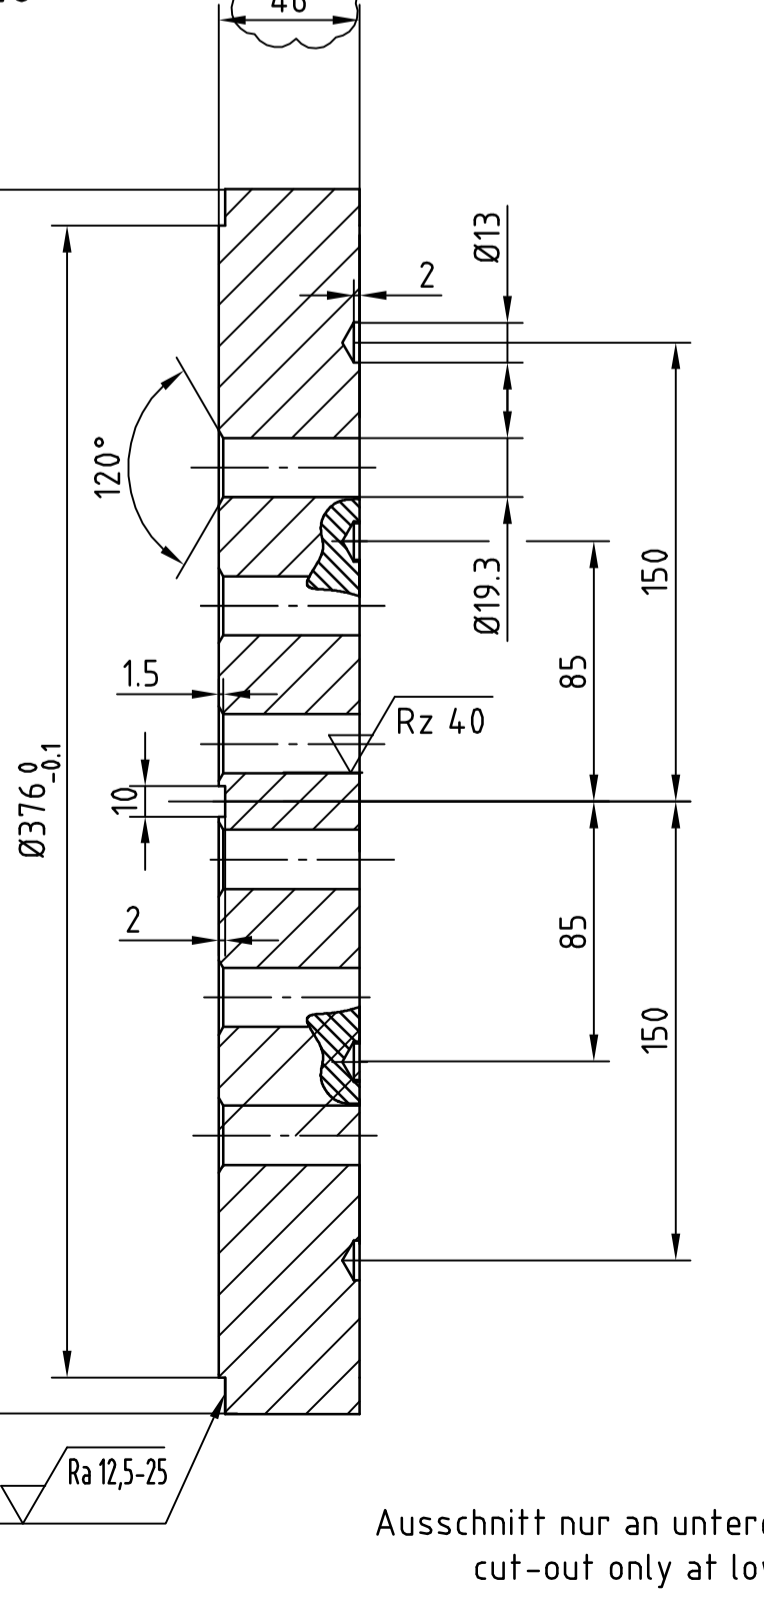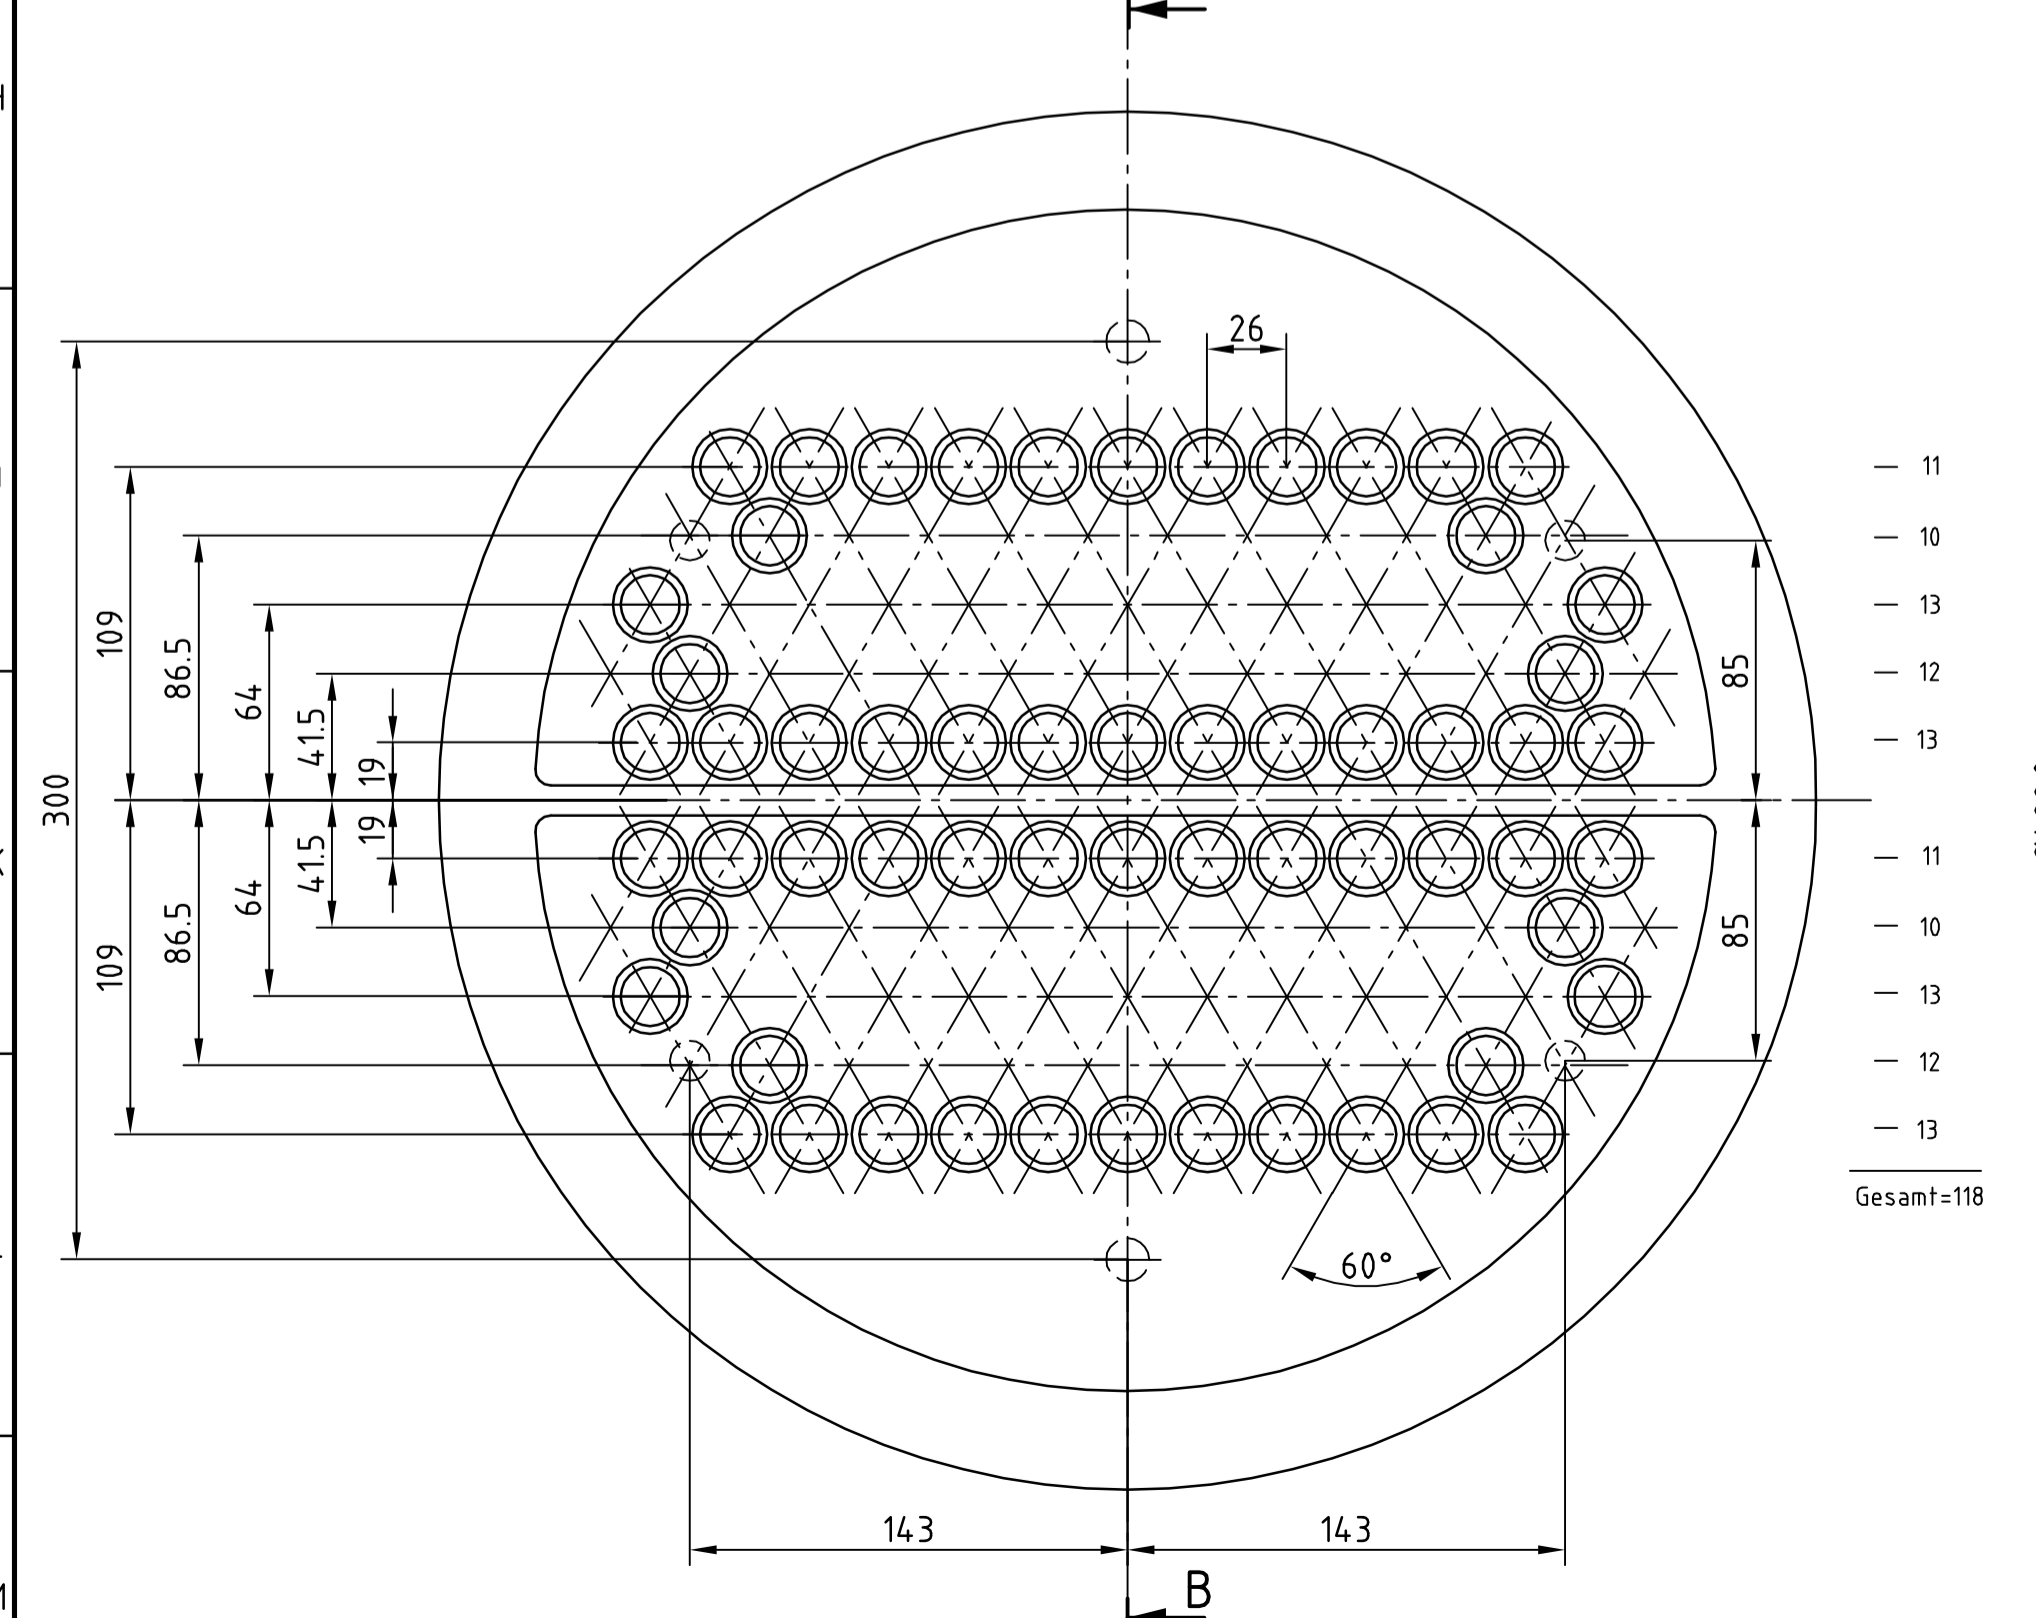

**STUTZENTABELLE / NOZZLES**

FLANSCH (LOCHANORDNUNG) NACH DIN EN 1092-1 UND 1092-2 / FLANGES (ARRANGEMENT OF HOLES) ACC. DIN EN 1092-1 AND 1092-2

Stützen-Nr. NOZZLE-NO.	DN NOM PIPE SIZE	PN NOM PRESS. RATING	Dicht-Fläche FACING	Flanschart FLANGE TYPE	Benennung DESCRIPTION
N1	6"	300	RF	B16.5	Gas Inlet
N2	6"	300	RF	B16.5	Gas Outlet
N3	3"	300	RF	B16.5	Cooling Water Inlet
N4	3"	300	RF	B16.5	Cooling Water Outlet
NP	-	-	-	-	-
E	-	-	-	-	-

**BEHALTER DATEN / VESSEL DATA**

Komm. Nr. / COM. NO.	100522-2-2400
Anzahl / QUANTITY	1
Fabrik Nr. / SERIAL NO.	13755
Baujahr / YEAR OF CONSTRUCTION	2014
Höchstzul. Betriebsüberdruck / MAX. ALLOW. WORKING GAUGE PRESSURE	bar -1/37
Höchstzul. Betriebstemperatur / MAX. ALLOW. WORKING TEMPERATURE	°C 120
Prüfüberdruck / TEST PRESSURE	bar 52,9
Inhalt / VOLUME	l 465
Medium	Erdgas/naturalgas
Korrosionszuschlag für drucktrag. Teile (ohne WT-Rohre) / CORROSIONS ALLOWANCE	mm 1,6
Höchstzul. Betriebsüberdruck / MAX. ALLOW. WORKING GAUGE PRESSURE	bar -1/37
Höchstzul. Betriebstemperatur / MAX. ALLOW. WORKING TEMPERATURE	°C 120
Prüfüberdruck / TEST PRESSURE	bar 49,4
Inhalt / VOLUME	l 78
Medium	Wasser/water
Korrosionszuschlag für drucktrag. Teile (ohne WT-Rohre) / CORROSIONS ALLOWANCE	mm 1
Schweißnahtfaktor / WELDING FACTOR	0,85

**Auslegungscodes / DESIGN CODE** ASME VIII div.1 (ohne U-Stamp)

Behälter-Kategorie / VESSEL-CATEGORY	Ausleg. u. Herstell. / DESIGN AND MANUFACTURING	
Gefahrenanalyse / Erstellung tech. Unterlagen / ESSENTIAL SAFETY REQUIREMENTS / TECHNICAL DOCUMENTATION		Silica
Entwurfprüfung / DESIGN-EXAMINATION		TÜV
Einzelprüfung (Schluß- und Druckprüfung) / UNIT VERIFICATION		TÜV
Betriebsanl. / Konformitätserkl. / CE-Kennzeichnung / OP-INSTRUCTION / DECLARATION OF CONFORMITY / CE-MARKING		Silica
Endabnahme / FINAL INSPECTION		Silica / Customer
Isolierung / Warm-Berührungsschutz / INSULATION HOT - P PROTECTIVE COATING		mm

Rev. Datum/DATE Name/NAME Änderung/MODIFICATION

4			
3			
2			
1	08.04.2014	ys	wallthickness, tube and baffle plate, material, Pos.15
0	24.02.14	mr	Erstausgabe / FIRST ISSUE


Komm.-Nr./COM.-NO.: 100522-2-2400 Projekt/PROJECT: LNG Bolivia

Gez./DESIGN: 24.02.14 mr  
 Gepr./CHK: 24.02.14 we

**SILICA Verfahrenstechnik GmbH**  
 Wiltstraße 24, 13509 Berlin


Maßstab/SCALE: 1:10, 1:5, 1:2,5  
 Zchn. Nr./DRAW. NO.: 153/161  
 Seite/SHEET: 1 von/OF: 1

Ersetzt durch/REPL. FOR: 02204-E-01  
 Ersetzt durch/SUPERSEDED BY:

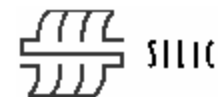


Pos. pos.	Menge quantity	Benennung description	Abmessung dimension	Werkstoff/Norm material/standard	Dokumentation/Atteste documentation/certificate	Gewicht in kg weight in kg	Lv. st.	Rev.
1	2	Klöpferboden torispherical head DIN 28011 Nennwanddicke = Mindestwanddicke US-Prüfung gem. SA-435  mit V-Naht 37,5 ° - aussen, Ansatzdicke vom zyl. Bord innen unter 15° beigedreht  Wärmebehandlung gem. UG-79  heat treatment in acc. to ASME UG 79	Ø406,4 x 20 - VA Ansatz s = 14 mm	ASTM A516 Gr. 60	3.1 ASME II	41,3/St. pc.		1
<b>2</b>								
3	1	Mantel, geschweißt aus Blech plate	Ø406,4 x 14 x ~ 4616 aus Bl. 14 x ~4616 x 1233	ASTM A516 Gr. 60	3.1 ASME II	625		1
4	2	Rohr, nahtlos tube ASME B36.10	Ø168,3 x 10,97 x 131 (80S)	ASTM A516 Gr. 60	3.1 ASME II	5,5/St. pc.		1
5	2	Rohr, nahtlos tube ASME B36.10	Ø88,9 x 7,62 x ~140 (80S)	ASTM A516 Gr. 60	3.1 ASME II	2/St. pc.		1
6	118	Rohr, nahtlos tube DIN 28181 Tol. KI 1	Ø19,05 x 2,11 x 5000	ASTM A179	3.1 ASME II	4,4/St. pc.		
7	2	Vorschweißflansch welding neck flange ASME B16.5 Dichtfläche: kleiner Rücksprung  facing: small female	16" 300 lbs J = 378,4 mm	ASTM A105	3.1 ASME II	106/St. pc.		1

Komnr./comn	100522							Titel/title	Liefertermin/delivery dt.
Aktennr./ref.	2-2400							<b>Precooler</b>	
Aufgabe/aband	1	1	08.04.2014	wallthickness, tube and baffle plate, material, Pos.	ys	rr		Zeichngsnr/drawingno.	
Datum/date	21.02.2014	0	21.02.2014	Erstausführung/first issue	mr	we		<b>Ø406,4 x 5000 02Z04-E-01/</b>	<b>153-161</b>
Name	mr	Rev.	Datum/date	Änderung/change	Erstellt/issue	Geprüft/check		Seite/page	1 +

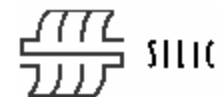

Pos. pos.	Menge quantity	Benennung description	Abmessung dimension	Werkstoff/Norm material/standard	Dokumentation/Atteste documentation/certificate	Gewicht in kg weight in kg	Lv. st.	Rev.
8	2	Vorschweißflansch welding neck flange ASME B16.5 Dichtfläche RF  facing: RF	6" 300 lbs J = 146,4	ASTM A105	3.1 ASME II	19,1/St. pc.		1
9	2	Vorschweißflansch welding neck flange ASME B16.5 Dichtfläche RF  facing: RF	3" 300 lbs J = 73,7	ASTM A105	3.1 ASME II	6,9/St. pc.		1
10	2	Vorschweißflansch welding neck flange ASME B16.5 Dichtfläche RF  facing: RF	16" 300 lbs J = 378,4 mm	ASTM A105	3.1 ASME II	106/St. pc.		1
11	2	Blech plate DIN EN 10029	10 x 131 x 142	ASTM A516 Gr. 60	2.2	1,5/St. pc.		1
12	2	Blech plate DIN EN 10029	10 x 90 x 220	ASTM A516 Gr. 60	3.1 ASME II	1,6/St. pc.		1
13	1	Blech plate DIN EN 10029	3 x 130 x 140	ASTM A516 Gr. 60	2.2	0,4		1
14	1	Blech plate DIN EN 10029	5 x 105 x 140	ASTM A516 Gr. 60	3.1 ASME II	0,6		1
15								1


Komnr./comn	100522						Titel/title	Liefertermin/delivery dt.
Aktenr./ref.	2-2400						<b>Precooler</b>	Zeichngsnr/drawingno.
Aufgabe/aband	1	1	08.04.2014	wallthickness, tube and baffle plate, material, Pos.	ys	rr	<b>Ø406,4 x 5000 02Z04-E-</b>	<b>153-161</b>
Datum/date	21.02.2014	0	21.02.2014	Erstausführung/first issue	mr	we	<b>01/</b>	Seite/page
Name	mr	Rev.	Datum/date	Änderung/change	Erstellt/issue	Geprüft/check		2 +

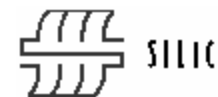

Pos. pos.	Menge quantity	Benennung description	Abmessung dimension	Werkstoff/Norm material/standard	Dokumentation/Atteste documentation/certificate	Gewicht in kg weight in kg	Lv. st.	Rev.
16	2	Blech plate DIN EN 10029 1 x gebohrt als Festlager 1 x gebohrt als Loslager  1 x drilled for fixpoint 1 x drilled for loose point	15 x 160 x 400	ASTM A516 Gr. 60	2.2	7,5/St. pc.		1
17	2	Blech plate DIN EN 10029	15 x 330 x 390	ASTM A516 Gr. 60	2.2	15/St. pc.		1
18	4	Blech plate DIN EN 10029	15 x 167 x 279	ASTM A516 Gr. 60	2.2	5,5/St. pc.		1
19	2	Blech plate DIN EN 10029	15 x 167 x 183	ASTM A516 Gr. 60	2.2	3,5/St. pc.		1
20	4	Blech plate DIN EN 10029	15 x 167 x 279	ASTM A516 Gr. 60	2.2	5,5/St. pc.		1
21	2	Blech plate DIN EN 10029	15 x 167 x 183	ASTM A516 Gr. 60	2.2	3,5/St. pc.		1
22	2	Abdichtstreifen flat sealing strip DIN EN 10058 Flach	FI 25 x 10 x 4495	ASTM A516 Gr. 60	2.2	8,8/St. pc.		1


23

Komnr./comn	100522							Titel/title	Liefertermin/delivery dt.
Aktenr./ref.	2-2400							<b>Precooler</b> <b>Ø406,4 x 5000 02Z04-E-</b> <b>01/</b>	Zeichnsnr/drawingno.
Aufgabe/aband	1	1	08.04.2014	wallthickness, tube and baffle plate, material, Pos.	ys	rr			<b>153-161</b>
Datum/date	21.02.2014	0	21.02.2014	Erstausführung/first issue	mr	we			Seite/page
Name	mr	Rev.	Datum/date	Änderung/change	Erstellt/issue	Geprüft/check			3 +

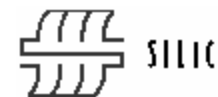

Pos. pos.	Menge quantity	Benennung description	Abmessung dimension	Werkstoff/Norm material/standard	Dokumentation/Atteste documentation/certificate	Gewicht in kg weight in kg	Lv. st.	Rev.
24	2	Rohrboden aus Blech tube plate DIN EN 10029 mit US-Flächenprüfung gemäß DIN EN 10160, Klasse S2 bzw. E2	BI 46 x Ø400	ASTM A516 Gr. 60	3.1 ASME II	45,5/St. pc.		1
25	12	Umlenblech baffle plate DIN EN 10029 davon 6 Stück mit Ausschnitt für Entleerung  6 parts with cut-out for drain	BI 8 x Ø376	ASTM A516 Gr. 60	2.2	4,6/St. pc.		1
26	1	Blech plate DIN EN 10029	BI 8 x 378 x 288	ASTM A516 Gr. 60	3.1 ASME II	6,8		1
27	1	Rund round DIN EN 10060	Rd 12 x 4125	ASTM A516 Gr. 60	2.2	3,7		1
28	5	Rund round DIN EN 10060	Rd 12 x 4495	ASTM A516 Gr. 60	2.2	4/St. pc.		1
29	3	Spiraldichtring spiral wound gasket ASME B 16.20 NPS 16", für Vor-und Rücksprung,schmal, RF, mit separatem Steg 8mm  1 x für Druckprobe 1 x Reserve  for small male and female 1 x for pressure test 1 x reserve	Ø400 x Ø376 x 3,5	Spiroflex mit Graphiteinlage SpV1	---	0,1/St. pc.		

Komnr./comn	100522								Titel/title	Liefertermin/delivery dt.
Aktenr./ref.	2-2400								<b>Precooler</b> Ø406,4 x 5000 02Z04-E-01/	Zeichngsnr/drawingno.
Aufgabe/aband	1	1	08.04.2014	wallthickness, tube and baffle plate, material, Pos.	ys	rr		153-161		
Datum/date	21.02.2014	0	21.02.2014	Erstausführung/first issue	mr	we			Seite/page	4 +
Name	mr	Rev.	Datum/date	Änderung/change	Erstellt/issue	Geprüft/check				

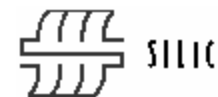

Pos. pos.	Menge quantity	Benennung description	Abmessung dimension	Werkstoff/Norm material/standard	Dokumentation/Atteste documentation/certificate	Gewicht in kg weight in kg	Lv. st.	Rev.
30	3	Spiraldichtring spiral wound gasket ASME B 16.20 NPS 16", für Vor-und Rücksprung,schmal, RF  1 x für Druckprobe 1 x Reserve  for small male and female 1 x for pressure test 1 x reserve	Ø400 x Ø376 x 3,5	Spiroflex mit Graphiteinlage SpV1	---	0,1/St. pc.		
31	42	Gewindebolzen stud bolt ANSI B18.2 davon 2 Reserve	1 1/4"-8UN x 250 mm	ASTM A193-B7	3.1 ASME II	1,5/St. pc.		1
32	84	Sechskantmutter hex. nut ANSI B18.2.2 davon 4 Reserve	1 1/4"-8UN	ASTM A194-B7	3.1 ASME II	0,2/St. pc.		1
33	4	Verschlussschraube lock screw DIN 906	G1/4A	5.6		0,1/St. pc.		1
34	3	Halbrundniet snap rivet DIN 660	A4 x 12	Al	---			
35	1	Niet rivet DIN 7338	A6 x 15	Cu	---			
36	1	Silica-Schild name plate		1.4301	---	0,1		

Komnr./comn	100522						Titel/title	Liefertermin/delivery dt.
Aktenr./ref.	2-2400						<b>Precooler</b>	
Aufgabe/aband	1	1	08.04.2014	wallthickness, tube and baffle plate, material, Pos.	ys	rr	Ø406,4 x 5000 02Z04-E-	Zeichngsnr/drawingno.
Datum/date	21.02.2014	0	21.02.2014	Erstausführung/first issue	mr	we	<b>01/</b>	<b>153-161</b>
Name	mr	Rev.	Datum/date	Änderung/change	Erstellt/issue	Geprüft/check		Seite/page 5 +



**SILICA**

# Technical Datasheet

Draw.-No.: 153-158

Title: Regenerationsgas cooler

Rev.-No.: 1

Description: Reg.-gas cooler 02Z04-E-05

Page: 1 / 4

Comm.-No.: V 100522-2-2400

Ident.-No.: 13754

Project: LNG Bolivia

Customer-No.: Ros Roca Indox Cryo-Energy S.L.

Quantity: 1

## Operating Conditions

		Shell Side	Tube Side
Medium:	--	Natural Gas	Cooling Water
Flow rate:	Nm <sup>3</sup> /h	1700	27,5
Operating pressure:	bar (g)	18,5	4
Inlet temperature:	°C	200	32
Outlet temperature:	°C	37	37
Quantity of condensate:	kg/h	Ø 38 (max. ~ 110)	-
Quantity of heat:	kJ/h	571070	571070
Standard density:	kg/m <sup>3</sup>	0,831	992,64
dyn. viscosity:	Ns/m <sup>2</sup>	1,4E-05	7,6E-04
spec. heat:	J/kgK	2480	4178
Heat conductivity:	W/mK	0,045	0,622
Fouling factor:	m <sup>2</sup> K/W		2,5E-04
Loss of pressure:	mbar	28,5	71,3
Exchange surface (required):	m <sup>2</sup>	12,15	
Exchange surface (real):	m <sup>2</sup>	16,16	13,36

## Design Conditions

		Shell Side	Tube Side
max. pressure:	bar	-1/ 37	-1/ 37
Test pressure:	bar	53	53
max. temperature:	°C	270	270
Welding factor:	v	0,85	0,85
Corrosion allowance:	mm	0	0

## Regulations, Tests

				Regulations		
Preliminary check:	X	TÜV	Penetrant test:	X		
Works test:	X	TÜV	Leak test:	X		Work stand.
Pressure test:	X	TÜV	Acceptance:	X		DIN
Design Review:	X	TÜV	X-Ray test:	X		AD
			US test:			ASME x TÜV
						TEMA - x

Rev.-No.:	0	1	2	3	4	5	6	7
Date:	11.11.2013	20.6.2014						
Name:	Cf	rr						





**SILICA**

# Technical Datasheet

Title:

Regenerationsgas cooler

Description:

Reg.-gas cooler 02Z04-E-05

Draw.-No.: 153-158

Rev.-No.: 1

Page: 2 / 4

Comm.-No.: V 100522-2-2400

Ident.-No.: 13754

Project: LNG Bolivia

Customer-No.: Ros Roca Indox Cryo-Energy S.L.

Quantity: 1

## Technical Design

Design:	type	BET	Position:	
Diameter of shell:	mm	323,9	vertical	<input type="checkbox"/>
Length of bundle:	mm	3000	horizontal	<input checked="" type="checkbox"/>
Tube number:	piece	82	Expansion joint	<input type="checkbox"/>
Tube dimension:	mm	19,05 x 1,65	Deflector	<input type="checkbox"/>
Tube System:		<input checked="" type="radio"/> <input type="radio"/> <input type="radio"/> <input type="checkbox"/>	Tube bundle:	
Number of passes:	--	2	welded in	<input type="checkbox"/>
Number of tube rows:	piece	10	pull-out	<input checked="" type="checkbox"/>
Tubes in pass partition lane:	piece	7	Tubes:	
Turning vanes:	piece	18	welded in	<input checked="" type="checkbox"/>
Distance between turning vanes:	mm	140	rolled in	<input type="checkbox"/>
Dimension of pass partition lane:	mm	48,81	rolled and welded	<input type="checkbox"/>
Chamber length:	mm	310		
Number of sealing flats (pairs):	piece	1		

## Dimension, Material

Description	Dimension	Material	Certificate
Shell:	Ø 323,9 x 3000	ASTM A312 Gr. TP321	3.1 ASME II
Formed heads:	Ø 323,9	ASTM A240 Gr. 321	3.1 ASME II
Floating head:		ASTM A240 Gr. 321	3.1 ASME II
Tube sheet:		ASTM A240 Gr. 321	3.1 ASME II
Tubes:	Ø 19,05 x 1,65	ASTM A312 (TP316/316L)	3.1 ASME II
Guiding plates:		ASTM A240 Gr. 321	3.1 ASME II
Nozzles shell side			
- Flanges:		ASTM A182 Gr. F321	3.1 ASME II
- Tubes:		ASTM A312 Gr. TP321	3.1 ASME II
- Bolts and Nuts:		ASTM A193 Gr.B8/194 Gr.8	3.1 ASME II
- Gaskets:		spiral wounded gasket	3.1 ASME II
Nozzles tube side			
- Flanges:		ASTM A182 Gr. F321	3.1 ASME II
- Tubes:		ASTM A312 Gr. TP321	3.1 ASME II
- Bolts and Nuts:		ASTM A193 Gr.B8/194 Gr.8	3.1 ASME II
- Gaskets:		spiral wounded gasket	3.1 ASME II
Supports:		ASTM A240 Gr. 321	3.1 ASME II

Weights: kg empty: 870 in operation: 970 filled with water: 1015

Rev.-No.:	0	1	2	3	4	5	6	7	
Date:	11.11.2013	20.6.2014							
Name:	Cf	rr							





**SILICA**

# Technical Datasheet

Draw.-No.: 153-158

Title: Regenerationsgas cooler

Rev.-No.: 1

Description: Reg.-gas cooler 02Z04-E-05

Page: 3 / 4

Comm.-No.: V 100522-2-2400

Ident.-No.: 13754

Project: LNG Bolivia

Customer-No.: Ros Roca Indox Cryo-Energy S.L.

Quantity: 1

## Accessories

Anchor / Fixing bolts:			Nameplate:	X
Saddle:	X			
Plugs:			Counterflanges:	
Lifting lugs	X		Gaskets and bolts:	X
Support for pressure test:			Earth connection:	X
Insulation holder:				
Insulation:	X			
Thickness of insulation:		30	mm	
Insulation cover:				

## Surface Treatment

Sandblasting:		Sa 2,5 DIN 55928 part 4			
Primer:	X	Color type:	Intertherm 751CSA	TSD:	50 μm
Intermediate coat:		Color type:		TSD:	μm
Top coat:		Color type:		TSD:	μm
Pickling and neutralisation:	X	VDI 2532 / DIN 28051			
Glass bead blasting					

## Nozzle Table

No.	Description	DN	PN	Nozzle Tubes	Sealing face	ANSI
N1	Inlet	3"	Cl.300	Ø88,9x7,62	RF	B16.5
N2	Outlet	3"	Cl.300	Ø88,9x7,62	RF	B16.5
N3	Cooling Water Inlet	3"	Cl.300	Ø88,9x7,62	RF	B16.5
N4	Cooling Water Outlet	3"	Cl.300	Ø88,9x7,62	RF	B16.5
N5						
N6						
N7						
N8						
N9						
N10						
N11						
N12						
N13						
NP	Nameplate					
E1	Earthing					

Rev.-No.:	0	1	2	3	4	5	6	7	
Date:	11.11.2013	20.6.2014							
Name:	Cf	rr							



SILICA

# Technical Datasheet

Draw.-No.: 153-158

Title: Regenerationsgas cooler

Rev.-No.: 1

Description: Reg.-gas cooler 02Z04-E-05

Page: 4 / 4

Comm.-No.: V 100522-2-2400

Ident.-No.: 13754

Project: LNG Bolivia

Customer-No.: Ros Roca Indox Cryo-Energy S.L.

Quantity: 1

## Dimension Sheet

s. dwg: ZCHG2-2400Regeneration-Gas-Cooler Ø323,9x3000\_02Z04-E-05\_100522\_153-158

Rev.-No.:	0	1	2	3	4	5	6	7	
Date:	11.11.2013	20.6.2014							
Name:	Cf	rr							